STATE OF VERMONT
AGENCY OF TRANSPORTATION

TRAFFIC SIGN SUMMARY SHEET 3

WILMINGTON
COLDBROOK ROAD

DIRECTION	MILEMARKER, STATION, OR SIGN NUMBER	LOCATION	MANUAL ON UNIFORM TRAFFIC DEVICES OR STATE CODE	SIGN DIMENSIONS WIDTH	SIGN DIMENSIONS HEIGHT	SHEETING REMARKS	SIGN LEGEND	NEW SIGNS "A"	NEW SIGNS "B"	EXISTING SIGNS RETAIN	EXISTING SIGNS SALVAGE FROM	EXISTING SIGNS SALVAGE TO	EXISTING SIGNS REMOVE	EXISTING POST RETAIN	EXISTING POST REMOVE	NO. OF NEW POSTS	SQUARE STEEL (in) 1.75 lb/ft 1.88	SQUARE STEEL (in) 2.00 lb/ft 2.42	SQUARE STEEL (in) 2.50 lb/ft 3.35	TUBULAR STEEL O/(in) FOUNDATION	TUBULAR STEEL O/(in) 3.00 lb/ft 7.60	TUBULAR STEEL O/(in) 3.50 lb/ft 9.00	TUBULAR STEEL O/(in) 4.00 lb/ft 10.80	TUBULAR STEEL O/(in) 5.00 lb/ft 14.60	SIGN FRAME REQUIRED	REMARKS SHSM = STANDARD HIGHWAY SIGN & MARKING BOOK	SIGN DETAIL DETAIL IN SHSM	SIGN DETAIL DETAIL ON SHEET NUMBER	SIGN DETAIL STANDARD SHEET NUMBER
SB	MM 2.186 LT	F	W1-2R	30	30			6.25								1		~~15~~ 15.25								INSTALL A NEW CURVE RIGHT SIGN AND POST LOCATED 628' SOUTH OF POLE # 47/GMP/60	X		
SB	MM 2.186 LT	F	W13-1P	18	18			2.25																		INSTALL A NEW ADVISORY SPEED PLAQUE BENEATH AND ON THE SAME POST AS THE NEW W1-2R SIGN LOCATED 628' SOUTH OF POLE # 47/GMP/60	X		
NB	MM 2.260 RT	A	R2-1	24	30			5.00								1		~~15~~ 13.25								INSTALL A NEW SPEED LIMIT SIGN AND POST LOCATED 238' SOUTH OF AND ACROSS FROM POLE # 47/GMP/60	X		
SB	MM 2.206 LT	F	R2-1	24	30			5.00					X		X	1		~~15~~ 13.5								REPLACE THE EXISTING SPEED LIMIT SIGN AND POST LOCATED 238' SOUTH OF POLE # 47/GMP/60	X		
SB	MM 2.305 LT	F	W1-5L	30	30			6.25								1		~~15~~ 15.5								INSTALL A NEW WINDING ROAD SIGN AND POST LOCATED ADJACENT TO POLE # 47/GMP/60	X		
SB	MM 2.305 LT	F	W13-1P	18	18			2.25																		INSTALL A NEW ADVISORY SPEED PLAQUE BENEATH AND ON THE SAME POST AS THE NEW W1-5L LOCATED ADJACENT TO POLE # 47/GMP/60	X		
NB	MM 2.578 RT	A B	D3-1	60	12			5.00					X		X	2		11.5 ~~30~~ 12.25								REPLACE THE EXISTING STREET NAME SIGN ON TWO NEW POSTS LOCATED 1441' NORTH OF AND ACROSS FROM POLE # 47/GMP/60		11	
SB	MM 2.679 LT	F	R2-1	24	30								X		X											REMOVE EXISTING SPEED LIMIT SIGN AND POST LOCATED 1975' NORTH OF POLE # 47/GMP/60			
SB	MM 2.701 LT	F	R2-1	24	30			5.00								1		~~15~~ 13.5								INSTALL A NEW SPEED LIMIT SIGN AND POST LOCATED 153' SOUTH OF THE WILMINGTON DOVER TOWN LINE	X		
SB	MM 2.701 LT	H G	D3-1	42	12			3.50					X			1		~~15~~ 11								INSTALL A NEW STREET NAME SIGN AND POST LOCATED 153' SOUTH OF THE WILMINGTON DOVER TOWN LINE		10	
SB	MM 2.730 LT	H G	VD-024	72	10		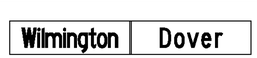	5.00								2		11 30 11								INSTALL A NEW TOWN LINE SIGN ON TWO NEW POSTS LOCATED AT THE WILMINGTON, DOVER TOWN LINE		11	
										EA	EA	EA	EA	EA	EA		FT	FT	FT		LB	LB	LB	LB					
													~~3~~ 4		3			150											
								SF	SF	EA				EA		EA	FT			EA	LB								
								45.50					~~3~~ 4		3	10		~~150~~ 127.75											

FINAL POST LENGTHS ARE TO BE DETERMINED IN THE FIELD. POST SIZES ARE COMPUTED BASED ON INFORMATION FURNISHED ON THE STANDARD SHEETS AND THE VTRANS "SIGN POST DESIGN GUIDE".

PROJECT NAME: STATEWIDE SOUTHEAST REGION
PROJECT NUMBER: STP HRRR(18)

FILE NAME: 13K034wrk.dgn
PLOT DATE: 1/3/2014
PROJECT LEADER: P. COBURN
DRAWN BY: N. PATTIS
DESIGNED BY: N. PATTIS
CHECKED BY: B. GROSE
COLDBROOK RD. TRAFFIC SIGN SUMM. SHEET 3 SHEET 25 OF 34