STATE OF VERMONT
AGENCY OF TRANSPORTATION

TRAFFIC SIGN SUMMARY SHEET 3

DORSET
MAD TOM ROAD

DIRECTION	MILEMARKER, STATION, OR SIGN NUMBER	LOCATION	MANUAL ON UNIFORM TRAFFIC DEVICES OR STATE CODE	SIGN DIMENSIONS WIDTH	SIGN DIMENSIONS HEIGHT	SHEETING REMARKS	SIGN LEGEND	NEW SIGNS "A"	NEW SIGNS "B"	EXISTING SIGNS RETAIN	EXISTING SIGNS SALVAGE FROM	EXISTING SIGNS SALVAGE TO	EXISTING SIGNS REMOVE	EXISTING POST RETAIN	EXISTING POST REMOVE	NO. OF NEW POSTS	SQUARE STEEL (in) 1.75 lb/ft 1.88	SQUARE STEEL (in) 2.00 lb/ft 2.42	SQUARE STEEL (in) 2.50 lb/ft 3.35	TUBULAR STEEL O/(in) FOUNDATION	TUBULAR STEEL O/(in) 3.00 lb/ft 7.60	TUBULAR STEEL O/(in) 3.50 lb/ft 9.00	TUBULAR STEEL O/(in) 4.00 lb/ft 10.80	TUBULAR STEEL O/(in) 5.00 lb/ft 14.60	SIGN FRAME REQUIRED	REMARKS SHSM = STANDARD HIGHWAY SIGN & MARKING BOOK	SIGN DETAIL DETAIL IN SHSM	SIGN DETAIL DETAIL ON SHEET NUMBER	SIGN DETAIL STANDARD SHEET NUMBER
SB	MM 0.637 LT	F	W1-1R	30	30			6.25								1		14.0 ~~15~~									INSTALL A NEW TURN RIGHT SIGN AND POST LOCATED 58' NORTH OF AND ACROSS FROM POLE # NET/22/25/25	X		
SB	MM 0.658 LT	F	W1-1R	30	30								X		X												REMOVE THE EXISTING TURN RIGHT SIGN AND POST LOCATED 11' SOUTH OF POLE # 64/26/NET/26			
SB	MM 0.672 RT	A	R2-1	24	30								X		X												REMOVE EXISTING SPEED LIMIT SIGN AND POST LOCATED 63' NORTH OF AND ACROSS FROM POLE # 64/26/NET/26			
NB	MM 0.676 RT	A	R2-1	24	30			5.00								1		13.0 ~~15~~									INSTALL A NEW SPEED LIMIT SIGN AND POST LOCATED 79' SOUTH OF AND ACROSS FROM POLE # NET/27/27	X		
SB	MM 0.676 LT	A	R2-1	24	30			5.00								1		13.25 ~~15~~									INSTALL A NEW SPEED LIMIT SIGN AND POST LOCATED 79' SOUTH OF POLE # NET/27/27	X		
SB	MM 0.788 LT	A	R2-1	24	30								X		X												REMOVE EXISTING SPEED LIMIT SIGN AND POST LOCATED ADJACENT TO POLE # NET/29/64/29			
NB	MM 1.428 RT	A	W4-5	30	30			6.25					X		X	1		13.0 ~~15~~									REPLACE THE EXISTING HIDDEN DRIVE RIGHT SIGN AND POST LOCATED 11' NORTH OF POLE # NET/44/45	X		
NB	MM 1.579 RT	A	R2-1	24	30			5.00								1		12.75 ~~15~~									INSTALL A NEW SPEED LIMIT SIGN AND POST LOCATED 808' NORTH OF POLE # NET/44/45	X		
SB	MM 1.579 LT	F	R2-1	24	30			5.00					X		X	1		13.25 ~~15~~									REPLACE EXISTING SPEED LIMIT SIGN AND POST LOCATED 808' NORTH OF AND ACROSS FROM POLE # NET/44/45	X		
NB	MM 1.692 RT	A	R2-1	24	30								X		X												REMOVE EXISTING SPEED LIMIT SIGN LOCATED 1405' NORTH OF POLE # NET/44/45			
NB	MM 1.692 RT	A	VR-023B	24	30								X														REMOVE EXISTING FINE FOR LITTERING SIGN AND POST LOCATED 1405' NORTH OF POLE # NET/44/45			
NB	MM 2.323 RT	A	W1-3R	30	30			6.25								1		13.75 ~~15~~									INSTALL A NEW REVERSE TURN RIGHT SIGN AND POST LOCATED 79' SOUTH OF MAILBOX # 153	X		
SB	MM 2.359 LT	E	W1-6R	48	24		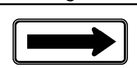	8.00								2		25.0 ~~30~~									INSTALL A NEW LARGE RIGHT ARROW ON TWO NEW POSTS LOCATED 111' NORTH OF AND ACROSS FROM MAILBOX # 153	X		
								EA	EA	EA	EA	EA	EA				FT	FT ~~135~~ 118.0	FT		LB	LB	LB	LB					
											7		6																	
								SF 46.75	SF	EA 7				EA 6		EA 9	FT ~~135~~ 118.0			EA	LB								

FINAL POST LENGTHS ARE TO BE DETERMINED IN THE FIELD. POST SIZES ARE COMPUTED BASED ON INFORMATION FURNISHED ON THE STANDARD SHEETS AND THE VTRANS "SIGN POST DESIGN GUIDE".

PROJECT NAME: STATEWIDE SOUTHWEST REGION
PROJECT NUMBER: STP HRRR(19)

FILE NAME: 13k036wrk.dgn
PROJECT LEADER: P. COBURN
DESIGNED BY: N. PATTIS
DORSET TRAFFIC SIGN SUMMARY SHEET 3

PLOT DATE: 12/20/2013
DRAWN BY: N. PATTIS
CHECKED BY: B. GROSE
SHEET 23 **OF** 87