STATE OF VERMONT
AGENCY OF TRANSPORTATION

TRAFFIC SIGN SUMMARY SHEET 3

LEICESTER
LEICESTER-WHITING ROAD

DIRECTION	MILEMARKER, STATION, OR SIGN NUMBER	LOCATION	MANUAL ON UNIFORM TRAFFIC DEVICES OR STATE CODE	SIGN DIMENSIONS WIDTH	SIGN DIMENSIONS HEIGHT	SHEETING REMARKS	SIGN LEGEND	NEW SIGNS ''A''	NEW SIGNS ''B''	EXISTING SIGNS RETAIN	EXISTING SIGNS SALVAGE FROM	EXISTING SIGNS SALVAGE TO	EXISTING SIGNS REMOVE	EXISTING POST RETAIN	EXISTING POST REMOVE	NO. OF NEW POSTS	SQUARE STEEL (in) 1.75 lb/ft 1.88	SQUARE STEEL (in) 2.00 lb/ft 2.42	SQUARE STEEL (in) 2.50 lb/ft 3.35	TUBULAR STEEL O/(in) FOUNDATION	TUBULAR STEEL O/(in) 3.00 lb/ft 7.60	TUBULAR STEEL O/(in) 3.50 lb/ft 9.00	TUBULAR STEEL O/(in) 4.00 lb/ft 10.80	TUBULAR STEEL O/(in) 5.00 lb/ft 14.60	SIGN FRAME REQUIRED	REMARKS SHSM = STANDARD HIGHWAY SIGN & MARKING BOOK	SIGN DETAIL DETAIL IN SHSM	SIGN DETAIL DETAIL ON SHEET NUMBER	SIGN DETAIL STANDARD SHEET NUMBER
WB	MM 0.592 LT	F	W10-1	36	36					X				X												RETAIN EXISTING RAILROAD CROSSING SIGN AND POST LOCATED 195' EAST OF AND ACROSS FROM POLE # 121			
EB	MM 0.631 RT	A	R2-1	24	30			5.00								1		14.0 ~~15~~								INSTALL A NEW SPEED LIMIT SIGN AND POST LOCATED 401' EAST OF POLE # 121	X		
WB	MM 0.631 LT	F	R2-1	24	30			5.00								1		13.25 ~~15~~								INSTALL A NEW SPEED LIMIT SIGN AND POST LOCATED 401' EAST OF AND ACROSS FROM POLE # 121	X		
EB	MM 0.724 RT	A	R2-1	24	30								X		X											REMOVE EXISTING SPEED LIMIT SIGN AND POST LOCATED 84' WEST OF AND ACROSS FROM POLE # 202			
WB	MM 0.729 LT	F	R2-5	24	30								X		X											REMOVE EXISTING REDUCED SPEED AHEAD SIGN AND POST LOCATED 58' WEST OF POLE # 202			
WB	MM 0.729 LT	F	W3-5	36	36			9.00								2		27.0 ~~30~~								INSTALL A NEW 30 MPH AHEAD SIGN ON TWO NEW POSTS LOCATED 58' WEST OF POLE # 202	X		
EB	MM 1.538 RT	A	W3-1	30	30			6.25					X		X	1		14.75 ~~15~~								REPLACE EXISTING STOP AHEAD SIGN AND POST LOCATED 37' WEST OF AND ACROSS FROM POLE # NET/1/185/2	X		
EB	MM 1.555 RT	A	W2-4	30	30								X		X											REMOVE EXISTING T INTERSECTION SIGN AND POST LOCATED 53' EAST OF AND ACROSS FROM POLE # NET/1/185/2			
EB	MM 1.570 RT	A	D1-1	72	12		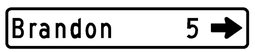	6.00								2		26.0 ~~30~~								INSTALL A NEW D-BOARD SIGN ON TWO NEW POSTS LOCATED 158' WEST OF AND ACROSS FROM POLE # NET/1/184/2232/1/25T		17	
EB	MM 1.570 RT	A	D1-1	72	12			6.00																		INSTALL A NEW D-BOARD SIGN BENEATH AND ON THE SAME POSTS AS THE NEW D1-1 LOCATED 158' WEST OF AND ACROSS FROM POLE # NET/1/184/2232/1/25T		17	
WB	MM 1.591 LT	F	R2-1	24	30			5.00					X		X	1		13.75 ~~15~~								REPLACE EXISTING SPEED LIMIT SIGN AND POST LOCATED 48' WEST OF POLE # NET/1/184/2232/1/25T	X		
EB	MM 1.616 RT	A	R1-1	30	30			6.25					X		X	1		13.75 ~~15~~								REPLACE EXISTING STOP SIGN AND POST LOCATED 85' EAST OF AND ACROSS FROM POLE # NET/1/184/2232/1/25T	X		
										EA 1			EA 6	EA 1	EA 6		FT	FT ~~135~~ 122.50	FT		LB	LB	LB	LB					
								SF 48.50	SF	EA 7				EA 7		EA 9	FT ~~135~~ 122.50			EA	LB								

FINAL POST LENGTHS ARE TO BE DETERMINED IN THE FIELD. POST SIZES ARE COMPUTED BASED ON INFORMATION FURNISHED ON THE STANDARD SHEETS AND THE VTRANS "SIGN POST DESIGN GUIDE".

PROJECT NAME: STATEWIDE SOUTHWEST REGION
PROJECT NUMBER: STP HRRR(19)

FILE NAME: 13k036wrk.dgn
PROJECT LEADER: P. COBURN
DESIGNED BY: N. PATTIS
PLOT DATE: 12/20/2013
DRAWN BY: N. PATTIS
CHECKED BY: B. GROSE