STATE OF VERMONT
AGENCY OF TRANSPORTATION

TRAFFIC SIGN SUMMARY SHEET 5

LEICESTER
LEICESTER-WHITING ROAD

DIRECTION	MILEMARKER, STATION, OR SIGN NUMBER	LOCATION	MANUAL ON UNIFORM TRAFFIC DEVICES OR STATE CODE	SIGN DIMENSIONS WIDTH	SIGN DIMENSIONS HEIGHT	SHEETING REMARKS	SIGN LEGEND	NEW SIGNS ''A''	NEW SIGNS ''B''	EXISTING SIGNS RETAIN	EXISTING SIGNS SALVAGE FROM	EXISTING SIGNS SALVAGE TO	EXISTING SIGNS REMOVE	EXISTING POST RETAIN	EXISTING POST REMOVE	NO. OF NEW POSTS	SQUARE STEEL (in) 1.75 lb/ft 1.88	SQUARE STEEL (in) 2.00 lb/ft 2.42	SQUARE STEEL (in) 2.50 lb/ft 3.35	TUBULAR STEEL O (in) FOUNDATION	TUBULAR STEEL O (in) 3.00 lb/ft 7.60	TUBULAR STEEL O (in) 3.50 lb/ft 9.00	TUBULAR STEEL O (in) 4.00 lb/ft 10.80	TUBULAR STEEL O (in) 5.00 lb/ft 14.60	SIGN FRAME REQUIRED	REMARKS (SHSM = STANDARD HIGHWAY SIGN & MARKING BOOK)	SIGN DETAIL: DETAIL IN SHSM	SIGN DETAIL: DETAIL ON SHEET NUMBER	SIGN DETAIL: STANDARD SHEET NUMBER
WB	MM 1.906 LT	E	WI-6R	48	24			8.00								2		25.5 ~~30~~									INSTALL A NEW LARGE RIGHT ARROW SIGN ON TWO NEW POSTS LOCATED 42' EAST OF POLE # 35/7	X		
WB	MM 1.907 LT	F	WI-6L	48	24			8.00								2		25.25 ~~30~~									INSTALL A NEW LARGE LEFT ARROW SIGN ON TWO NEW POSTS LOCATED 47' EAST OF POLE # 35/7	X		
WB	MM 1.929 LT	E	WI-6R	48	24			8.00								2		25.0 ~~30~~									INSTALL A NEW LARGE RIGHT ARROW SIGN ON TWO NEW POSTS LOCATED 5' EAST OF POLE # 223/34/I-9/8	X		
WB	MM 1.930 LT	F	WI-6L	48	24			8.00								2		24.5 ~~30~~									INSTALL A NEW LARGE LEFT ARROW SIGN ON TWO NEW POSTS LOCATED 11' EAST OF POLE # 223/34/I-9/8	X		
WB	MM 1.930 LT	E	WI-6R	48	24								X		X												REMOVE EXISTING LARGE RIGHT ARROW SIGN AND POST LOCATED 11' EAST OF POLE # 223/34/I-9/8			
WB	MM 1.930 LT	F	OMI-I	18	18								X														REMOVE EXISTING 9-BALL SIGN LOCATED 11' EAST OF POLE # 223/34/I-9/8			
WB	MM 1.963 LT	F	WI-IL	30	30			6.25								I		15									INSTALL A NEW TURN LEFT SIGN AND POST LOCATED 42' EAST OF POLE # NET/31/33	X		
WB	MM 1.963 LT	F	W13-IP	18	18			2.25																			INSTALL A NEW 20 MPH PLAQUE BENEATH WI-IL SIGN LOCATED 42' EAST OF POLE # NET/31/33	X		
EB	MM 1.974 RT	A	R2-I	24	30			5.00					X		X	I		12.75 ~~15~~									REPLACE EXISTING SPEED LIMIT SIGN AND POST LOCATED 100' EAST OF AND ACROSS FROM POLE # NET/31/33	X		
EB	MM 2.648 RT	A	WI-I	30	30			6.25								I		15.5 ~~15~~									INSTALL A NEW TURN LEFT SIGN AND POST LOCATED 16' WEST OF POLE # 15/20/15/223/15	X		
EB	MM 2.648 RT	A	W13-IP	18	18			2.25																			INSTALL A NEW 25 MPH PLAQUE BENEATH AND ON THE SAME POST AS THE NEW WI-I SIGN LOCATED 16' WEST OF POLE # 15/20/15/223/15	X		
EB	MM 2.670 RT	A B	WI-8L WI-8R	18 18	24 24			3.00 3.00								I		13.75 ~~15~~									INSTALL TWO NEW CHEVRONS ON ONE POST USING A BRACKET. LOCATE IT 100' EAST OF POLE # 15/20/15/223/15	X		
EB	MM 2.685 RT	A B	WI-8L WI-8R	18 18	24 24		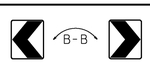	3.00 3.00								I		13.0 ~~15~~									INSTALL TWO NEW CHEVRONS ON ONE POST USING A BRACKET. LOCATE IT 211' WEST OF POLE # 13	X		
EB	MM 2.700 RT	A B	WI-8L WI-8R	18 18	24 24		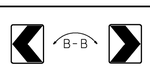	3.00 3.00								I		13.0 ~~15~~									INSTALL TWO NEW CHEVRONS ON ONE POST USING A BRACKET. LOCATE IT 132' WEST OF POLE # 13	X		
WB	MM 2.770 LT	F	WI-2R	30	30								X		X												REMOVE EXISTING CURVE RIGHT SIGN AND POST LOCATED 26' EAST OF AND ACROSS FROM POLE # 12/NET/12			
								SF 72.00	SF	EA 4			EA 3			EA 14		FT ~~210~~ 183.25			EA		LB						

FINAL POST LENGTHS ARE TO BE DETERMINED IN THE FIELD. POST SIZES ARE COMPUTED BASED ON INFORMATION FURNISHED ON THE STANDARD SHEETS AND THE VTRANS "SIGN POST DESIGN GUIDE".

PROJECT NAME: STATEWIDE SOUTHWEST REGION
PROJECT NUMBER: STP HRRR(19)

FILE NAME: 13k036wrk.dgn **PLOT DATE:** 12/20/2013
PROJECT LEADER: P. COBURN **DRAWN BY:** N. PATTIS
DESIGNED BY: N. PATTIS **CHECKED BY:** B. GROSE
LEICESTER TRAFFIC SIGN SUMMARY SHEET 5 **SHEET** 32 **OF** 87