STATE OF VERMONT
AGENCY OF TRANSPORTATION

TRAFFIC SIGN SUMMARY SHEET 6

LEICESTER
LEICESTER-WHITING ROAD

DIRECTION	MILEMARKER, STATION, OR SIGN NUMBER	LOCATION	MANUAL ON UNIFORM TRAFFIC DEVICES OR STATE CODE	SIGN DIMENSIONS WIDTH	SIGN DIMENSIONS HEIGHT	SHEETING REMARKS	SIGN LEGEND	NEW SIGNS "A"	NEW SIGNS "B"	EXISTING SIGNS RETAIN	EXISTING SIGNS SALVAGE FROM	EXISTING SIGNS SALVAGE TO	EXISTING SIGNS REMOVE	EXISTING POST RETAIN	EXISTING POST REMOVE	NO. OF NEW POSTS	SQUARE STEEL (in) 1.75 lb/ft 1.88	SQUARE STEEL (in) 2.00 lb/ft 2.42	SQUARE STEEL (in) 2.50 lb/ft 3.35	TUBULAR STEEL O/(in) FOUNDATION	TUBULAR STEEL O/(in) 3.00 lb/ft 7.60	TUBULAR STEEL O/(in) 3.50 lb/ft 9.00	TUBULAR STEEL O/(in) 4.00 lb/ft 10.80	TUBULAR STEEL O/(in) 5.00 lb/ft 14.60	SIGN FRAME REQUIRED	REMARKS SHSM = STANDARD HIGHWAY SIGN & MARKING BOOK	SIGN DETAIL DETAIL IN SHSM	SIGN DETAIL DETAIL ON SHEET NUMBER	SIGN DETAIL STANDARD SHEET NUMBER
WB	MM 2.770 LT	F	W1-1R	30	30			6.25								1		15.5 ~~15~~									INSTALL A NEW TURN RIGHT SIGN AND POST LOCATED 26' EAST OF AND ACROSS FROM POLE # 12/NET/12	X		
WB	MM 2.770 LT	F	W13-1P	18	18			2.25																			INSTALL A NEW ADVISORY SPEED PLAQUE BENEATH AND ON THE SAME POST AS THE NEW W1-1R SIGN LOCATED 26' EAST OF AND ACROSS FROM POLE # 12/NET/12	X		
EB	MM 2.963 RT	A	TOWN SIGN	30	30								X		X												REMOVE EXISTING SCHOOL AHEAD SIGN AND POST LOCATED 53' EAST OF POLE # 8/NET/8			
EB	MM 2.963 RT	A	R2-1	24	30								X														REMOVE EXISTING SPEED LIMIT SIGN AND POST LOCATED 53' EAST OF POLE # 8/NET/8			
EB	MM 2.963 RT	A	W3-5	36	36			9.00								2		29.75 ~~30~~									INSTALL A NEW 30 MPH AHEAD SIGN ON TWO NEW POSTS LOCATED 53' EAST OF POLE # 8/NET/8	X		
EB	MM 2.985 RT	A	R2-1	24	30			5.00					X			1		14.0 ~~15~~									INSTALL A NEW SPEED LIMIT SIGN AND POST LOCATED 79' WEST OF POLE # 7/7	X		
WB	MM 2.985 LT	F	R2-1	24	30			5.00					X		X	1		14.5 ~~15~~									REPLACE EXISTING SPEED LIMIT SIGN AND POST LOCATED 79' WEST OF AND ACROSS FROM POLE # 7/7	X		
EB	MM 3.057 RT	A	S1-1	36	36	FYG		9.00								2		25.0 ~~30~~									INSTALL A NEW SCHOOL SYMBOL SIGN ON TWO NEW POST LOCATED ADJACENT TO POLE # 223/5/75-20/5	X		
EB	MM 3.057 RT	A	S4-3P	24	8	FYG		1.33																			INSTALL A NEW SCHOOL PLAQUE BENEATH AND ON THE SAME POST AS THE NEW S1-1 SIGN LOCATED ADJACENT TO POLE # 223/5/75-20/5	X		
EB	MM 3.083 RT	A	W3-1	30	30			6.25								1		14.0 ~~15~~									INSTALL A NEW STOP AHEAD SIGN AND POST LOCATED 11' WEST OF POLE # 4/4	X		
EB	MM 3.094 RT	A	W3-1	30	30								X		X												REMOVE EXISTING STOP AHEAD SIGN AND POST LOCATED 48' EAST OF POLE # 4/4			
WB	MM 3.094 LT	H	R1-1	30	30			6.25					X		X	1		13.25 ~~15~~									REPLACE EXISTING STOP SIGN AND POST LOCATED 48' EAST OF AND ACROSS FROM POLE # 4/4	X		
WB	MM 3.140 RT	E F	D3-1	60	12		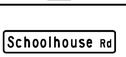	5.00					X		X	2		22.75 ~~30~~									REPLACE EXISTING STREET NAME SIGN ON TWO NEW POSTS LOCATED 11' WEST OF POLE # 2/2		15	
WB	MM 3.140 LT	F	D4-2	24	30			5.00					X		X	1		13.25 ~~15~~									REPLACE EXISTING PARK AND RIDE SIGN AND POST LOCATED 11' WEST OF POLE # 2/2	X		
WB	MM 3.161 LT	F	S1-1	36	36	FYG		9.00								2		25.5 ~~30~~									INSTALL A NEW SCHOOL SYMBOL SIGN ON TWO NEW POSTS LOCATED 100' EAST OF POLE # 2/2	X		
										EA	EA	EA	EA ~~7~~ 8	EA	EA 6		FT	FT ~~210~~ 187.50	FT		LB	LB	LB	LB					
								SF 69.33	SF	EA ~~7~~ 8				EA 6		EA 14	FT ~~210~~ 187.50			EA	LB								

FINAL POST LENGTHS ARE TO BE DETERMINED IN THE FIELD. POST SIZES ARE COMPUTED BASED ON INFORMATION FURNISHED ON THE STANDARD SHEETS AND THE VTRANS "SIGN POST DESIGN GUIDE".

PROJECT NAME: STATEWIDE SOUTHWEST REGION
PROJECT NUMBER: STP HRRR(19)

FILE NAME: 13k036wrk.dgn **PLOT DATE:** 12/20/2013
PROJECT LEADER: P. COBURN **DRAWN BY:** N. PATTIS
DESIGNED BY: N. PATTIS **CHECKED BY:** B. GROSE
LEICESTER TRAFFIC SIGN SUMMARY SHEET 6 **SHEET** 33 **OF** 87