STATE OF VERMONT
AGENCY OF TRANSPORTATION

TRAFFIC SIGN SUMMARY SHEET 9

LEICESTER

DIRECTION	MILEMARKER, STATION, OR SIGN NUMBER	LOCATION	MANUAL ON UNIFORM TRAFFIC DEVICES OR STATE CODE	SIGN DIMENSIONS WIDTH	SIGN DIMENSIONS HEIGHT	SHEETING REMARKS	SIGN LEGEND	NEW SIGNS "A"	NEW SIGNS "B"	EXISTING SIGNS RETAIN	EXISTING SIGNS SALVAGE FROM	EXISTING SIGNS SALVAGE TO	EXISTING SIGNS REMOVE	EXISTING POST RETAIN	EXISTING POST REMOVE	NO. OF NEW POSTS	SQUARE STEEL (in) 1.75 lb/ft 1.88	SQUARE STEEL (in) 2.00 lb/ft 2.42	SQUARE STEEL (in) 2.50 lb/ft 3.35	TUBULAR STEEL O/(in) FOUNDATION	TUBULAR STEEL O/(in) 3.00 lb/ft 7.60	TUBULAR STEEL O/(in) 3.50 lb/ft 9.00	TUBULAR STEEL O/(in) 4.00 lb/ft 10.80	TUBULAR STEEL O/(in) 5.00 lb/ft 14.60	SIGN FRAME REQUIRED	REMARKS SHSM = STANDARD HIGHWAY SIGN & MARKING BOOK	SIGN DETAIL DETAIL IN SHSM	SIGN DETAIL DETAIL ON SHEET NUMBER	SIGN DETAIL STANDARD SHEET NUMBER
NB	MM 0.064 LT	F	W3-1	30	30			6.25								1		13.75 ~~15~~									INSTALL A NEW STOP AHEAD SIGN AND POST LOCATED 5' NORTH OF POLE # 44A/NET/1/18	X		
NB	MM 0.109 LT	F	W3-1	30	30								X		X												REMOVE EXISTING STOP AHEAD SIGN AND POST LOCATED 37' SOUTH OF AND ACROSS FROM POLE # 223/45/178A			
							MEMOE ROAD																						
NB	MM 0.016 RT	C D	D3-1	36	12		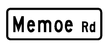	3.00					X		X	1		11.5 ~~15~~									REPLACE EXISTING STREET NAME SIGN AND POST LOCATED ADJACENT TO POLE # 223/34		14	
SB	MM 0.016 LT	F	R1-2	36	36			4.50					X		X	1		13.25 ~~15~~									REPLACE EXISTING YIELD SIGN AND POST LOCATED ACROSS FROM POLE # 223/34	X		
NB	MM 0.032 RT	A	R2-1	24	30			5.00					X		X	1		12.5 ~~15~~									REPLACE EXISTING SPEED LIMIT SIGN AND POST LOCATED 85' NORTH OF POLE # 223/34	X		
							BULLOCK ROAD																						
EB	MM 0.010 LT	H G	D3-1	42	12			3.50					X		X	1		13.0 ~~15~~									REPLACE THE EXISTING STREET NAME SIGN AND POST LOCATED 211' EAST OF POLE # 65		13	
EB	MM 0.010 LT	F	R1-1	30	30			6.25					X														REPLACE EXISTING STOP SIGN BENEATH AND ON THE SAME POST AS THE NEW D3-1 SIGN LOCATED 211' EAST OF POLE # 65	X		
WB	MM 0.015 RT	A	TOWN SIGN	30	30								X		X												REMOVE EXISTING SLOW SIGN AND POST LOCATED 185' EAST OF AND ACROSS FROM POLE # 65			
WB	MM 0.015 RT	A	R2-1	24	30			5.00								1		12.75 ~~15~~									INSTALL A NEW SPEED LIMIT SIGN AND POST LOCATED 185' EAST OF AND ACROSS FROM POLE #65	X		
WB	MM 0.061 RT	A	R2-1	24	30								X		X												REMOVE EXISTING SPEED LIMIT SIGN AND POST LOCATED 58' WEST OF AND ACROSS FROM POLE # 65			
										EA	EA	EA	EA	EA	EA		FT	FT ~~90~~ 76.75	FT				LB	LB	LB	LB				
								SF 33.50	SF	EA 8				EA 7		EA 6	FT ~~90~~ 76.75			EA	LB								

FINAL POST LENGTHS ARE TO BE DETERMINED IN THE FIELD. POST SIZES ARE COMPUTED BASED ON INFORMATION FURNISHED ON THE STANDARD SHEETS AND THE VTRANS "SIGN POST DESIGN GUIDE".

PROJECT NAME: STATEWIDE SOUTHWEST REGION
PROJECT NUMBER: STP HRRR(19)

FILE NAME: 13k036wrk.dgn
PROJECT LEADER: P. COBURN
DESIGNED BY: N. PATTIS
PLOT DATE: 12/20/2013
DRAWN BY: N. PATTIS
CHECKED BY: B. GROSE
LEICESTER TRAFFIC SIGN SUMMARY SHEET 9
SHEET 36 **OF** 87