STATE OF VERMONT
AGENCY OF TRANSPORTATION

TRAFFIC SIGN SUMMARY SHEET 2

TINMOUTH
SNTH 140

DIRECTION	MILEMARKER, STATION, OR SIGN NUMBER	LOCATION	MANUAL ON UNIFORM TRAFFIC DEVICES OR STATE CODE	SIGN DIMENSIONS WIDTH	SIGN DIMENSIONS HEIGHT	SHEETING REMARKS	SIGN LEGEND	NEW SIGNS "A"	NEW SIGNS "B"	EXISTING SIGNS RETAIN	EXISTING SIGNS SALVAGE FROM	EXISTING SIGNS SALVAGE TO	EXISTING SIGNS REMOVE	EXISTING POST RETAIN	EXISTING POST REMOVE	NO. OF NEW POSTS	SQUARE STEEL (in) 1.75 lb/ft 1.88	SQUARE STEEL (in) 2.00 lb/ft 2.42	SQUARE STEEL (in) 2.50 lb/ft 3.35	TUBULAR STEEL O/(in) FOUNDATION	TUBULAR STEEL O/(in) 3.00 lb/ft 7.60	TUBULAR STEEL O/(in) 3.50 lb/ft 9.00	TUBULAR STEEL O/(in) 4.00 lb/ft 10.80	TUBULAR STEEL O/(in) 5.00 lb/ft 14.60	SIGN FRAME REQUIRED	REMARKS SHSM = STANDARD HIGHWAY SIGN & MARKING BOOK	SIGN DETAIL DETAIL IN SHSM	SIGN DETAIL DETAIL ON SHEET NUMBER	SIGN DETAIL STANDARD SHEET NUMBER
EB	MM 0.171 RT	A	W1-2L	30	30			6.25								1		14.25 ~~15~~									INSTALL A NEW CURVE LEFT SIGN AND POST LOCATED 5' WEST OF POLE # CTC/57/5T/53/172	X		
WB	MM 0.192 LT	F	W3-1	30	30		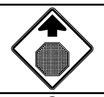						X		X											REMOVE EXISTING STOP AHEAD SIGN AND POST LOCATED 106' EAST OF AND ACROSS FROM POLE # CTC/57/5T/53/172			
WB	MM 0.219 LT	F	TOWN SIGN	30	30								X		X											REMOVE EXISTING WATCH FOR CHILDREN SIGN AND POST LOCATED 11' EAST OF AND ACROSS FROM POLE # CTC/59/535/1			
WB	MM 0.219 LT	F	S3-1	30	30								X													REMOVE EXISTING SCHOOL BUS STOP AHEAD SIGN AND POST LOCATED 11' EAST OF AND ACROSS FROM POLE # CTC/599/535/1			
WB	MM 0.219 LT	F	VW-060	30	30			6.25								2		29.0 ~~30~~									INSTALL A NEW HIDDEN DRIVES SIGN ON TWO NEW POSTS LOCATED 11' EAST OF AND ACROSS FROM POLE # CTC/59/535/1		12	
WB	MM 0.219 LT	F	S3-1	36	36	FYG		9.00																		INSTALL A NEW SCHOOL BUS STOP AHEAD SIGN BENEATH AND ON THE SAME POST AS THE NEW VW-60 SIGN LOCATED 11' EAST OF AND ACROSS FROM POLE # CTC/59/535/1	X		
WB	MM 0.256 LT	F	W1-2R	30	30			6.25								1		13.75 ~~15~~									INSTALL A NEW CURVE RIGHT SIGN AND POST LOCATED 5' WEST OF POLE # CTC/2/60/536/2	X		
EB	MM 0.531 RT	A	W1-4L	30	30			6.25								1		14.25 ~~15~~									INSTALL A NEW REVERSE CURVE LEFT SIGN AND POST LOCATED 53' EAST OF POLE # 535/8/CTC/66	X		
EB	MM 0.531 RT	A	W13-1P	18	18			2.25																		INSTALL A NEW ADVISORY SPEED PLAQUE BENEATH AND ON THE SAME POST AS THE NEW W1-4L SIGN LOCATED 53' EAST OF POLE # 535/8/CTC/66	X		
EB	MM 0.539 RT	A	W1-4L	30	30								X		X											REMOVE EXISTING REVERSE CURVE SIGN AND POST LOCATED 95' EAST OF POLE # 535/8/CTC/66			
EB	MM 0.539 RT	A	W13-1P	18	18								X													REMOVE EXISTING AADVISORY SPEED PLAQUE LOCATED 95' EAST OF POLE # 535/8/CTC/66			
EB	MM 0.539 RT - MM 0.592 RT	A B		6 6	8 8		(8) TYPE II 6"X 8" WHITE DELINEATORS																			INSTALL NEW DELINEATORS (8) BACK-TO-BACK 85 FEET APART ON 4 POSTS. INSTALL FIRST 95' EAST OF POLE # 535/8/CTC/66		4	
								SF 36.25	SF	EA 5				EA 3		EA 5		FT ~~75~~ 71.25		EA				LB					

FINAL POST LENGTHS ARE TO BE DETERMINED IN THE FIELD. POST SIZES ARE COMPUTED BASED ON INFORMATION FURNISHED ON THE STANDARD SHEETS AND THE VTRANS "SIGN POST DESIGN GUIDE".

PROJECT NAME: STATEWIDE SOUTHWEST REGION
PROJECT NUMBER: STP HRRR(19)

FILE NAME: 13k036wrk.dgn
PROJECT LEADER: P. COBURN
DESIGNED BY: N. PATTIS
TINMOUTH TRAFFIC SIGN SUMMARY SHEET 2

PLOT DATE: 12/20/2013
DRAWN BY: N. PATTIS
CHECKED BY: B. GROSE
SHEET 46 OF 87