STATE OF VERMONT
AGENCY OF TRANSPORTATION

TRAFFIC SIGN SUMMARY SHEET 3

TINMOUTH
SNTH 140

DIRECTION	MILEMARKER, STATION, OR SIGN NUMBER	LOCATION	MANUAL ON UNIFORM TRAFFIC DEVICES OR STATE CODE	SIGN DIMENSIONS WIDTH	SIGN DIMENSIONS HEIGHT	SHEETING REMARKS	SIGN LEGEND	NEW SIGNS "A"	NEW SIGNS "B"	EXISTING SIGNS RETAIN	EXISTING SIGNS SALVAGE FROM	EXISTING SIGNS SALVAGE TO	EXISTING SIGNS REMOVE	EXISTING POST RETAIN	EXISTING POST REMOVE	NO. OF NEW POSTS	SQUARE STEEL (in) 1.75 lb/ft 1.88	SQUARE STEEL (in) 2.00 lb/ft 2.42	SQUARE STEEL (in) 2.50 lb/ft 3.35	TUBULAR STEEL O/(in) FOUNDATION	TUBULAR STEEL O/(in) 3.00 lb/ft 7.60	TUBULAR STEEL O/(in) 3.50 lb/ft 9.00	TUBULAR STEEL O/(in) 4.00 lb/ft 10.80	TUBULAR STEEL O/(in) 5.00 lb/ft 14.60	SIGN FRAME REQUIRED	REMARKS (SHSM = STANDARD HIGHWAY SIGN & MARKING BOOK)	SIGN DETAIL: DETAIL IN SHSM	SIGN DETAIL: DETAIL ON SHEET NUMBER	SIGN DETAIL: STANDARD SHEET NUMBER
WB	MM 0.666 LT	E F		6 6	8 8		(2) TYPE II 6"X 8" WHITE DELINEATORS																			INSTALL 2 NEW DELINEATORS BACK-TO-BACK ON 1 NEW POST. INSTALL IT 16' WEST OF MAILBOX # 160		4	
WB	MM 0.679 LT	E F		6 6	8 8		(2) TYPE II 6"X 8" WHITE DELINEATORS																			INSTALL 2 NEW DELINEATORS BACK-TO-BACK ON 1 NEW POST. INSTALL IT ADJACENT TO POLE # 535/12		4	
WB	MM 0.692 LT	E F		6 6	8 8		(2) TYPE II 6"X 8" WHITE DELINEATORS																			INSTALL 2 NEW DELINEATORS BACK-TO-BACK ON 1 NEW POST. INSTALL IT 69' EAST OF POLE # 535/12		4	
WB	MM 0.700 LT	F	W1-4L	30	30			6.25								1		15								INSTALL A NEW REVERSE CURVE LEFT SIGN AND POST LOCATED 111' EAST OF POLE # 535/12	X		
WB	MM 0.700 LT	F	W13-1P	18	18			2.25																		INSTALL A NEW ADVISORY SPEED PLAQUE BENEATH AND ON THE SAME POST AS THE NEW W1-4L SIGN LOCATED 111' EAST OF POLE # 535/12	X		
EB	MM 0.750 RT - MM 0.798 RT	A B		6 6	8 8		(6) TYPE II 6"X 8" WHITE DELINEATORS									6										INSTALL NEW DELINEATORS (6) BACK-TO-BACK 85 FEET APART ON 3 POSTS. INSTALL FIRST 127' EAST OF POLE # CTC/71		4	
WB	MM 0.869 LT	F	W1-4R	30	30								X		X											REMOVE EXISTING REVERSE CURVE RIGHT SIGN AND POST LOCATED ADJACENT TO POLE # C-TEL/2/75			
EB	MM 1.020 RT	A	VW-276	30	30			6.25								1		13.0 ~~15~~								INSTALL A NEW DRIFTING SNOW SIGN AND POST LOCATED 21' WEST OF POLE # CTC/83 (MM 1.024)		12	
EB	MM 1.131 RT	A	W1-2R	30	30			6.25								1		14.25 ~~15~~								INSTALL A NEW CURVE RIGHT SIGN AND POST LOCATED 58' EAST OF POLE # CTC/83 (MM 1.120)	X		
WB	MM 1.200 LT	F	W1-2L	30	30		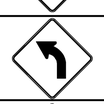	6.25								1		13.5 ~~15~~								INSTALL A NEW CURVE LEFT SIGN AND POST LOCATED ACROSS FROM POLE # 2-6-31	X		
EB	MM 1.242 RT	A	W2-7L	36	36		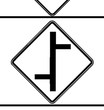	9.00								2		30								INSTALL A NEW OFFSET INTERSECTION SIGN ON TWO NEW POSTS LOCATED 5' EAST OF POLE # 2-6-32	X		
EB	MM 1.242 RT	A	W16-8P	48	15		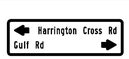	5.00																		INSTALL A NEW STREET NAME PLAQUE BENEATH AND ON THE SAME POSTS AS THE NEW W2-7L SIGN LOCATED 5' EAST OF POLE # 2-6-32		16	
								EA	EA	EA	EA	EA	EA				FT	FT	FT		LB	LB	LB	LB					
								SF 41.25	SF	EA 1				EA 1	EA 1	EA 6	FT ~~90~~ 85.75			EA	LB								

FINAL POST LENGTHS ARE TO BE DETERMINED IN THE FIELD. POST SIZES ARE COMPUTED BASED ON INFORMATION FURNISHED ON THE STANDARD SHEETS AND THE VTRANS "SIGN POST DESIGN GUIDE".

PROJECT NAME: STATEWIDE SOUTHWEST REGION
PROJECT NUMBER: STP HRRR(19)

FILE NAME: 13k036wrk.dgn
PROJECT LEADER: P. COBURN
DESIGNED BY: N. PATTIS
TINMOUTH TRAFFIC SIGN SUMMARY SHEET 3

PLOT DATE: 12/20/2013
DRAWN BY: N. PATTIS
CHECKED BY: B. GROSE