STATE OF VERMONT
AGENCY OF TRANSPORTATION

TRAFFIC SIGN SUMMARY SHEET 8

TINMOUTH
SNTH 140

DIRECTION	MILEMARKER, STATION, OR SIGN NUMBER	LOCATION	MANUAL ON UNIFORM TRAFFIC DEVICES OR STATE CODE	SIGN DIMENSIONS WIDTH	SIGN DIMENSIONS HEIGHT	SHEETING REMARKS	SIGN LEGEND	NEW SIGNS "A"	NEW SIGNS "B"	EXISTING SIGNS RETAIN	EXISTING SIGNS SALVAGE FROM	EXISTING SIGNS SALVAGE TO	EXISTING SIGNS REMOVE	EXISTING POST RETAIN	EXISTING POST REMOVE	NO. OF NEW POSTS	SQUARE STEEL (in) 1.75 lb/ft 1.88	SQUARE STEEL (in) 2.00 lb/ft 2.42	SQUARE STEEL (in) 2.50 lb/ft 3.35	TUBULAR STEEL O/(in) FOUNDATION	TUBULAR STEEL O/(in) 3.00 lb/ft 7.60	TUBULAR STEEL O/(in) 3.50 lb/ft 9.00	TUBULAR STEEL O/(in) 4.00 lb/ft 10.80	TUBULAR STEEL O/(in) 5.00 lb/ft 14.60	SIGN FRAME REQUIRED	REMARKS SHSM = STANDARD HIGHWAY SIGN & MARKING BOOK	SIGN DETAIL DETAIL IN SHSM	SIGN DETAIL DETAIL ON SHEET NUMBER	SIGN DETAIL STANDARD SHEET NUMBER
EB	MM 3.251 RT	A	M6-1	21	15								X													REMOVE EXISTING LEFT ARROW SIGN LOCATED 148' WEST OF AND ACROSS FROM POLE # CTC/80/93/67			
EB	MM 3.253 RT	D	R1-1	30	30			6.25					~~3~~ X		X	1		~~13.5~~ 15								REPLACE EXISTING STOP SIGN AND POST LOCATED 137' WEST OF AND ACROSS FROM POLE # CTC/80/93/67	X		
EB	MM 3.253 RT	D	R1-2	36	36			4.50					~~3~~ X		X	1		~~12.25~~ 15								REPLACE EXISTING YIELD SIGN AND POST LOCATED 137' WEST OF AND ACROSS FROM POLE # CTC/80/93/67	X		
EB	MM 3.253 RT	D	M1-5	30	24								X		X											REMOVE EXISTING ROUTE 140 SIGN AND POST LOCATED 137' WEST OF AND ACROSS FROM POLE # CTC/80/93/67			
EB	MM 3.253 RT	D	M6-1L	21	15								X													REMOVE EXISTING LEFT ARROW SIGN LOCATED 137' WEST OF AND ACROSS FROM POLE # CTC/80/93/67			
EB	MM 3.253 RT	A B	D3-1	66	12		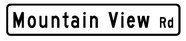						X		X											REMOVE EXISTING STREET NAME SIGN AND POST LOCATED 137' WEST OF AND ACROSS FROM POLE # CTC/80/93/67			
EB	MM 3.267 RT	A	R1-2	36	36			4.50					X		X	1		~~12.25~~ 15								REPLACE EXISTING YIELD SIGN AND POST LOCATED 63' WEST OF AND ACROSS FROM POLE # CTC/80/93/67	X		
WB	MM 3.267 LT	F	S1-1	36	36								X		X											REMOVE EXISTING SCHOOL SYMBOL SIGN AND POST LOCATED 63' WEST OF POLE # CTC/80/93/67			
WB	MM 3.267 LT	F	TOWN SIGN	36	36								X													REMOVE EXISTING SCHOOL ZONE SIGN LOCATED 63' WEST OF POLE # CTC/80/93/67			
WB	MM 3.279 LT	F	S1-1	36	36	FYG		9.00								2		~~28.0~~ 30								INSTALL A NEW SCHOOL SYMBOL SIGN ON TWO NEW POSTS LOCATED ADJACENT TO POLE # CTC/80/93/67	X		
WB	MM 3.279 LT	F	W16-9P	24	12	FYG		2.00																		INSTALL A NEW AHEAD PLAQUE BENEATH AND ON THE SAME POST AS THE NEW S1-1 SIGN LOCATED ADJACENT TO POLE # CTC/80/93/67	X		
EB	MM 3.310 RT	A	W1-2R	30	30								~~2~~ X		X											REMOVE EXISTING CURVE RIGHT SIGN AND POST LOCATED 164' EAST OF POLE # CTC/80/93/67			
EB	MM 3.310 RT	A	W1-5R	30	30			6.25								1		~~14.75~~ 15								INSTALL A NEW WINDING ROAD RIGHT SIGN AND POST LOCATED 164' EAST OF POLE # CTC/80/93/67	X		
								SF 32.50	SF	EA ~~10~~ 15				EA 7		EA 6	FT ~~90~~ 80.75			EA	LB							

FINAL POST LENGTHS ARE TO BE DETERMINED IN THE FIELD. POST SIZES ARE COMPUTED BASED ON INFORMATION FURNISHED ON THE STANDARD SHEETS AND THE VTRANS "SIGN POST DESIGN GUIDE".

PROJECT NAME: STATEWIDE SOUTHWEST REGION
PROJECT NUMBER: STP HRRR(19)

FILE NAME: 13k036wrk.dgn
PROJECT LEADER: P. COBURN
DESIGNED BY: N. PATTIS
TINMOUTH TRAFFIC SIGN SUMMARY SHEET 8

PLOT DATE: 12/20/2013
DRAWN BY: N. PATTIS
CHECKED BY: B. GROSE
SHEET 52 **OF** 87