STATE OF VERMONT
AGENCY OF TRANSPORTATION

TRAFFIC SIGN SUMMARY SHEET 2

WALLINGFORD
SNTH 140

DIRECTION	MILEMARKER, STATION, OR SIGN NUMBER	LOCATION	MANUAL ON UNIFORM TRAFFIC DEVICES OR STATE CODE	SIGN DIMENSIONS WIDTH	SIGN DIMENSIONS HEIGHT	SHEETING REMARKS	SIGN LEGEND	NEW SIGNS "A"	NEW SIGNS "B"	EXISTING SIGNS RETAIN	EXISTING SIGNS SALVAGE FROM	EXISTING SIGNS SALVAGE TO	EXISTING SIGNS REMOVE	EXISTING POST RETAIN	EXISTING POST REMOVE	NO. OF NEW POSTS	SQUARE STEEL (in) 1.75 lb/ft 1.88	SQUARE STEEL (in) 2.00 lb/ft 2.42	SQUARE STEEL (in) 2.50 lb/ft 3.35	TUBULAR STEEL O/(in) FOUNDATION	TUBULAR STEEL O/(in) 3.00 lb/ft 7.60	TUBULAR STEEL O/(in) 3.50 lb/ft 9.00	TUBULAR STEEL O/(in) 4.00 lb/ft 10.80	TUBULAR STEEL O/(in) 5.00 lb/ft 14.60	SIGN FRAME REQUIRED	REMARKS SHSM = STANDARD HIGHWAY SIGN & MARKING BOOK	SIGN DETAIL DETAIL IN SHSM	SIGN DETAIL DETAIL ON SHEET NUMBER	SIGN DETAIL STANDARD SHEET NUMBER
EB	MM 0.242 RT	A	W2-1R	30	30			6.25								1		13.5 ~~15~~								INSTALL A NEW CURVE RIGHT SIGN AND POST LOCATED 58' WEST OF MAILBOX # 2172	X		
WB	MM 0.290 LT - MM 0.423 LT	E F		6	8		(22) TYPE II 6"X 8" WHITE DELINEATORS																			INSTALL NEW DELINEATORS (22) BACK-TO-BACK 70 FEET APART ON 11 POSTS, INSTALL FIRST ONE ADJACENT TO POLE # CVP7/6T/VTEL/7		4	
EB	MM 0.291 RT	A	S3-1	36	36								X		X											REMOVE EXISTING SCHOOL BUS STOP AHEAD SIGN AND POST LOCATED 5' EAST OF AND ACROSS FROM POLE # CVP7/6T/VTEL/7			
WB	MM 0.527 LT	E F	D3-1	42	12		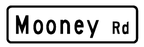	3.50					X		X	1		10.5 ~~15~~								REPLACE THE EXISTING STREET NAME SIGN AND POST LOCATED 11' EAST OF THE INTERSECTION OF MOONEY ROAD AND ROUTE 140		14	
WB	MM 0.527 LT	G	W14-1	30	30			6.25					X		X	1		13.25 ~~15~~								REPLACE EXISTING DEAD END SIGN AND POST LOCATED 11' EAST OF THE INTERSECTION OF MOONEY ROAD AND ROUTE 140	X		
EB	MM 0.589 RT	A	W1-1L	30	30			6.25					X		X	1		15.5 ~~15~~								REPLACE EXISTING TURN LEFT SIGN AND POST LOCATED 338' EAST OF AND ACROSS FROM THE INTERSECTION OF MOONEY ROAD AND ROUTE 140	X		
EB	MM 0.589 RT	A	W13-1P	18	18			2.25																		INSTALL A NEW ADVISORY SPEED PLAQUE BENEATH AND ON THE SAME POST AS THE NEW W1-1L SIGN LOCATED 338' EAST OF THE INTERSECTION OF MOONEY ROAD AND ROUTE 140	X		
EB	MM 0.617 RT	A	S3-1	36	36								X		X											REMOVE EXISTING SCHOOL BUS STOP AHEAD SIGN AND POST LOCATED 486' EAST OF AND OPPOSITE THE INTERSECTION OF MOONEY ROAD AND ROUTE 140			
EB	MM 0.645 RT	A B	W1-8L W1-8R	18 18	24 24					X				X												RETAIN EXISTING CHEVRONS LOCATED 634' EAST OF AND OPPOSITE THE INTERSECTION OF MOONEY ROAD AND ROUTE 140			
EB	MM 0.660 RT	A B	W1-8L W1-8R	18 18	24 24					X				X												RETAIN EXISTING CHEVRONS LOCATED 713' EAST OF AND OPPOSITE THE INTERSECTION OF MOONEY ROAD AND ROUTE 140			
EB	MM 0.675 RT	A B	W1-8L W1-8R	18 18	24 24		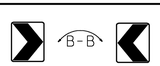			X				X												RETAIN EXISTING CHEVRONS LOCATED 792' EAST OF AND OPPOSITE THE INTERSECTION OF MOONEY ROAD AND ROUTE 140			
EB	MM 0.690 RT	A B	W1-8L W1-8R	18 18	24 24		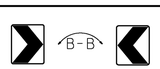			X				X												RETAIN EXISTING CHEVRONS LOCATED 871' EAST OF AND OPPOSITE THE INTERSECTION OF MOONEY ROAD AND ROUTE 140			
EB	MM 0.703 RT	A B	W1-8L W1-8R	18 18	24 24		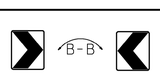			~~2~~ X			2	X				24.0			REPAIRED DAMAGED SIGN: REPLACED POSTS, REHUNG SIGNS						RETAIN EXISTING CHEVRONS LOCATED 940' EAST OF AND OPPOSITE THE INTERSECTION OF MOONEY ROAD AND ROUTE 140			
										EA ~~5~~ 6	EA	EA	EA ~~5~~ 7	EA 5	EA 5		FT	FT ~~60~~ 76.75	FT		LB	LB	LB	LB					
								SF 24.50	SF	EA ~~10~~ 13				EA 10		EA 4	FT ~~60~~ 76.75			EA	LB							

FINAL POST LENGTHS ARE TO BE DETERMINED IN THE FIELD. POST SIZES ARE COMPUTED BASED ON INFORMATION FURNISHED ON THE STANDARD SHEETS AND THE VTRANS "SIGN POST DESIGN GUIDE".

PROJECT NAME: STATEWIDE SOUTHWEST REGION
PROJECT NUMBER: STP HRRR(19)

FILE NAME: 13k036wrk.dgn
PROJECT LEADER: P. COBURN
DESIGNED BY: N. PATTIS
WALLINGFORD TRAFFIC SIGN SUMMARY SHEET 2

PLOT DATE: 12/20/2013
DRAWN BY: N. PATTIS
CHECKED BY: B. GROSE
SHEET 65 OF 87