STATE OF VERMONT
AGENCY OF TRANSPORTATION

TRAFFIC SIGN SUMMARY SHEET 2

WHITING
SHOREHAM-WHITING ROAD

DIRECTION	MILEMARKER, STATION, OR SIGN NUMBER	LOCATION	MANUAL ON UNIFORM TRAFFIC DEVICES OR STATE CODE	SIGN DIMENSIONS WIDTH	SIGN DIMENSIONS HEIGHT	SHEETING REMARKS	SIGN LEGEND	NEW SIGNS ''A''	NEW SIGNS ''B''	EXISTING SIGNS RETAIN	EXISTING SIGNS SALVAGE FROM	EXISTING SIGNS SALVAGE TO	EXISTING SIGNS REMOVE	EXISTING POST RETAIN	EXISTING POST REMOVE	NO. OF NEW POSTS	SQUARE STEEL (in) 1.75 lb/ft 1.88	SQUARE STEEL (in) 2.00 lb/ft 2.42	SQUARE STEEL (in) 2.50 lb/ft 3.35	TUBULAR STEEL O/(in) FOUNDATION	TUBULAR STEEL O/(in) 3.00 lb/ft 7.60	TUBULAR STEEL O/(in) 3.50 lb/ft 9.00	TUBULAR STEEL O/(in) 4.00 lb/ft 10.80	TUBULAR STEEL O/(in) 5.00 lb/ft 14.60	SIGN FRAME REQUIRED	REMARKS (SHSM = STANDARD HIGHWAY SIGN & MARKING BOOK)	SIGN DETAIL: DETAIL IN SHSM	SIGN DETAIL: DETAIL ON SHEET NUMBER	SIGN DETAIL: STANDARD SHEET NUMBER
EB	MM 0.433 RT	A	W2-2R	30	30			6.25								1		14.5 ~~15~~									INSTALL A NEW INTERSECTION RIGHT SIGN AND POST LOCATED 602' EAST OF AND ACROSS FROM POLE # 8/90	X		
EB	MM 0.433 RT	A	W16-8P	24	8			1.33																			INSTALL A NEW SIDE STREET PLAQUE BENEATH AND ON THE SAME POST AS THE NEW W2-2R SIGN LOCATED 602' EAST OF AND ACROSS FROM POLE # 8/90		17	
WB	MM 0.506 LT	G	W1-7	48	24			8.00								2		25.75 ~~30~~									INSTALL A NEW DOUBLE HEADED ARROW ON TWO NEW POSTS LOCATED ACROSS FROM THE CENTER OF WEST ROAD	X		
WB	MM 0.576 LT	F	W2-2L	30	30			6.25								1		15.25 ~~15~~									INSTALL A NEW INTERSECTION LEFT SIGN AND POST LOCATED ADJACENT TO POLE # 40T/83	X		
WB	MM 0.576 LT	F	W16-8P	24	8			1.33																			INSTALL A NEW STREET NAME PLAQUE BENEATH AND ON THE SAME POST AS THE NEW W2-2R SIGN LOCATED ADJACENT TO POLE # 40T/83		17	
EB	MM 1.133 RT	A	W3-1	30	30		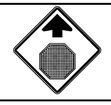						X		X												REMOVE EXISTING STOP AHEAD SIGN AND POST LOCATED 84' EAST OF AND ACROSS FROM POLE # 8/70			
EB	MM 1.133 RT	A	M2-1	21	15			2.19								1		14.25 ~~15~~									INSTALL A NEW JCT SIGN AND POST LOCATED 84' EAST OF AND ACROSS FROM POLE # 8/70			E-136B
EB	MM 1.133 RT	A	M1-5	24	24			4.00																			INSTALL A NEW VT ROUTE 30 SIGN BENEATH AND ON THE SAME POST AS THE NEW JCT SIGN LOCATED 84' EAST OF AND OPPOSITE POLE # 8/70			E-136B
EB	MM 1.198 RT	A	W3-1	36	36		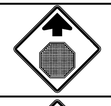	9.00								2		30.25 ~~30~~									INSTALL A NEW STOP AHEAD SIGN ON TWO NEW POSTS LOCATED 26' WEST OF AND ACROSS FROM POLE # 68	X		
WB	MM 1.198 LT	E	W3-1	36	36		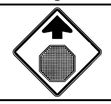	9.00								2		31.25 ~~30~~									INSTALL A NEW STOP AHEAD SIGN ON TWO NEW POSTS LOCATED 26' WEST OF POLE # 68	X		
WB	MM 1.262 LT	F	VR-017	24	30					X				X													RETAIN EXISTING LEGAL LOAD LIMIT SIGN AND POST LOCATED 74' EAST OF POLE # 67			
WB	MM 1.262 LT	F	R2-1	24	30			5.00																			INSTALL A NEW SPEED LIMIT SIGN BENEATH AND ON THE SAME POST AS THE EXISTING VR-017 SIGN LOCATED 74' EAST OF POLE # 67	X		
										EA 1	EA	EA	EA 1	EA 1	EA 1		FT 131.25	FT	FT			LB	LB	LB	LB					
								SF 52.35	SF	EA 2				EA 2		EA	FT ~~135~~ 131.25			EA		LB								

FINAL POST LENGTHS ARE TO BE DETERMINED IN THE FIELD. POST SIZES ARE COMPUTED BASED ON INFORMATION FURNISHED ON THE STANDARD SHEETS AND THE VTRANS "SIGN POST DESIGN GUIDE".

PROJECT NAME: STATEWIDE SOUTHWEST REGION
PROJECT NUMBER: STP HRRR(19)

FILE NAME: 13k036wrk.dgn
PROJECT LEADER: P. COBURN
DESIGNED BY: N. PATTIS
WHITING TRAFFIC SIGN SUMMARY SHEET 2

PLOT DATE: 12/20/2013
DRAWN BY: N. PATTIS
CHECKED BY: B. GROSE
SHEET 76 OF 87