STATE OF VERMONT
AGENCY OF TRANSPORTATION

TRAFFIC SIGN SUMMARY SHEET 4

WHITING
LEICESTER-WHITING ROAD

DIRECTION	MILEMARKER, STATION, OR SIGN NUMBER	LOCATION	MANUAL ON UNIFORM TRAFFIC DEVICES OR STATE CODE	SIGN DIMENSIONS WIDTH	SIGN DIMENSIONS HEIGHT	SHEETING REMARKS	SIGN LEGEND	NEW SIGNS "A"	NEW SIGNS "B"	EXISTING SIGNS RETAIN	EXISTING SIGNS SALVAGE FROM	EXISTING SIGNS SALVAGE TO	EXISTING SIGNS REMOVE	EXISTING POST RETAIN	EXISTING POST REMOVE	NO. OF NEW POSTS	SQUARE STEEL (in) 1.75 lb/ft 1.88	SQUARE STEEL (in) 2.00 lb/ft 2.42	SQUARE STEEL (in) 2.50 lb/ft 3.35	TUBULAR STEEL O (in) FOUNDATION	TUBULAR STEEL O (in) 3.00 lb/ft 7.60	TUBULAR STEEL O (in) 3.50 lb/ft 9.00	TUBULAR STEEL O (in) 4.00 lb/ft 10.80	TUBULAR STEEL O (in) 5.00 lb/ft 14.60	SIGN FRAME REQUIRED	REMARKS SHSM = STANDARD HIGHWAY SIGN & MARKING BOOK	SIGN DETAIL DETAIL IN SHSM	SIGN DETAIL DETAIL ON SHEET NUMBER	SIGN DETAIL STANDARD SHEET NUMBER
EB	MM 0.732 RT	A	W1-2R	30	30			6.25								1		15.25 ~~15~~									INSTALL A NEW CURVE LEFT SIGN AND POST LOCATED 116' EAST OF AND ACROSS FROM POLE # 8/48	X		
EB	MM 0.732 RT	A	W13-1P	18	18			2.25																			INSTALL A NEW ADVISORY SPEED PLAQUE BENEATH AND ON THE SAME POST AS THE NEW W1-2R SIGN LOCATED 116' EAST OF AND ACROSS FROM POLE # 8/48	X		
WB	MM 0.732 LT	F	W1-2L	30	30			6.25								1		13.75 ~~15~~									INSTALL A NEW CURVE LEFT SIGN AND POST LOCATED 116' EAST OF POLE # 8/48	X		
WB	MM 0.773 LT	F	W1-6L	48	24			8.00					X		X	2		25.75 ~~30~~									REPLACE EXISTING LARGE ARROW LEFT SIGN ON TWO NEW POSTS LOCATED 106' WEST OF POLE # 46	X		
WB	MM 0.796 LT	E	W1-6R	48	24			8.00					X		X	2		26.25 ~~30~~									REPLACE EXISTING LARGE ARROW RIGHT SIGN ON TWO NEW POSTS LOCATED 16' EAST OF POLE # 46	X		
WB	MM 0.850 LT	F	W1-2R	30	30			6.25					X		X	1		14.5 ~~15~~									REPLACE EXISTING CURVE RIGHT SIGN AND POST LOCATED 143' EAST OF POLE # 8/45	X		
WB	MM 0.850 LT	F	W13-1P	18	18			2.25																			INSTALL A NEW ADVISORY SPEED PLAQUE BENEATH AND ON THE SAME POST AS THE NEW W1-2R SIGN LOCATED 143' EAST OF POLE # 8/45	X		
WB	MM 0.940 LT	F	W1-2 R	30	30		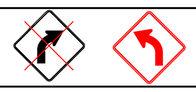						X		X												REMOVE EXISTING CURVE RIGHT SIGN AND POST LOCATED 269' WEST OF POLE # 8/41			
WB	MM 0.940 LT	F	W13-1P	18	18								X														REMOVE EXISTING ADVISORY SPEED PLAQUE LOCATED BENEATH EXISTING CURVE RIGHT SIGN 269' WEST OF POLE # 8/41			
EB	MM 1.015 RT - MM 1.176 RT	A B		6	8		(22) TYPE II - 6"X 8" WHITE DELINEATORS																				INSTALL NEW DELINEATORS (22) BACK-TO-BACK 85 FT APART ON 11 POSTS. INSTALL FIRST 111' WEST OF POLE # 8/40		4	
EB	MM 1.470 RT	A	S3-1	36	36	FYG		9.00								2		30.5 ~~30~~									INSTALL A NEW SCHOOL BUS STOP AHEAD SIGN ON TWO NEW POSTS LOCATED 42' WEST OF POLE LOCATED AT MM 1.478 AND 26' WEST OF THE EXISTING SCHOOL BUS STOP AHEAD SIGN (MM 1.475 RT)	X		
EB	MM 1.475 RT	A	S3-1	30	30								X		X												REMOVE EXISTING SCHOOL BUS STOP AHEAD SIGN AND POST LOCATED 16' WEST OF THE POLE AT MM 1.478 RT			
EB	MM 1.489 RT	A	W8-060	30	30			6.25					X		X	1		13.5 ~~15~~									REPLACE EXISTING HIDDEN DRIVES SIGN AND POST LOCATED 581' WEST OF AND ACROSS FROM POLE # 26		12	
								SF 54.50	SF	EA 7				EA 6		EA 10		FT ~~150~~ 139.50		EA		LB							

FINAL POST LENGTHS ARE TO BE DETERMINED IN THE FIELD. POST SIZES ARE COMPUTED BASED ON INFORMATION FURNISHED ON THE STANDARD SHEETS AND THE VTRANS "SIGN POST DESIGN GUIDE".

PROJECT NAME: STATEWIDE SOUTHWEST REGION
PROJECT NUMBER: STP HRRR(19)

FILE NAME: 13k036wrk.dgn
PROJECT LEADER: P. COBURN
DESIGNED BY: N. PATTIS
WHITING TRAFFIC SIGN SUMMARY SHEET 4

PLOT DATE: 12/20/2013
DRAWN BY: N. PATTIS
CHECKED BY: B. GROSE
SHEET 78 **OF** 87