TRAFFIC SIGN SUMMARY SHEET

STATE OF VERMONT
AGENCY OF TRANSPORTATION

MILEMARKER, STATION, OR SIGN NUMBER	SIGN LEGEND	SIGN DIMENSIONS EA	SIGN DIMENSIONS WIDTH (in)	SIGN DIMENSIONS HEIGHT (in)	NEW & SALVAGED SIGNS "A"	NEW & SALVAGED SIGNS "B"	SALV SIGN	SALV TIS	EXIST POST RETAIN	EXIST POST SALVAGE	NO. OF POSTS	FLANGED CHANNEL lb/ft 1.12	FLANGED CHANNEL lb/ft 2.0	FLANGED CHANNEL lb/ft 3.0	SQUARE STEEL (in) 1.75 (lb/ft 1.88)	SQUARE STEEL (in) 2.0 (lb/ft 2.42)	SQUARE STEEL (in) 2.5 (lb/ft 3.35)	ANCHOR	SLEEVE	TUBULAR ALUMINUM Ø (in) 3.0 (lb/ft 1.3)	TUBULAR ALUMINUM Ø (in) 4.0 (lb/ft 1.7)	TUBULAR ALUMINUM Ø (in) 4.0 MOD (lb/ft 1.7)	FOUNDATION	TUBULAR STEEL Ø (in) 3.0 (lb/ft 7.6)	TUBULAR STEEL Ø (in) 3.5 (lb/ft 9.0)	TUBULAR STEEL Ø (in) 4.0 (lb/ft 10.8)	TUBULAR STEEL Ø (in) 5.0 (lb/ft 14.6)	W-SHAPE STEEL FTG. SIZE 24"	W-SHAPE STEEL FTG. SIZE 30"	W-SHAPE STEEL WEIGHT	W-SHAPE STEEL POST SIZE	SIGN FRAME REQUIRED	REMARKS	SIGN DETAIL: DETAIL ON SHEET NUMBER	SIGN DETAIL: STD. SHEET NUMBER
												OPTION ITEMS																							
BARRE CITY QUARRY STREET																																			
1202+30, RT	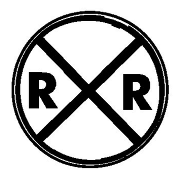	1	36	36	7.07						1					13.50 X		X															SHSM W10-1		E 190
1204+04, RT	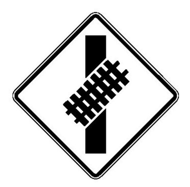	1	36	36	9.00						1					14.50 X		X															SHSM W10-12		
1204+81, RT	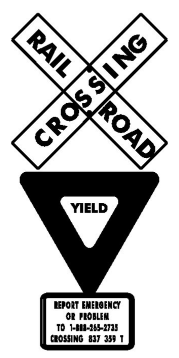	1 1 1	48 48 • 15	9 9 • 9	6.00 3.90 0.94						2					16.00 X + 16.00		X															SIGN POST SHALL INCLUDE 2-INCH WIDE RETROREFLECTIVE STRIPS ON BOTH SIDES PER SECTION 8B.03 OF THE LATEST EDITION OF MUTCD — SHSM R15-1 • SIZE = 36"x36"x36" — SHSM R1-2 ENLARGED VIEW BELOW — SHSM I-13		E 190
1205+18, LT		1 1 1	48 48 • 15	9 9 • 9	6.00 3.90 0.94						2					15.00 X + 15.75		X															SIGN POST SHALL INCLUDE 2-INCH WIDE RETROREFLECTIVE STRIPS ON BOTH SIDES PER SECTION 8B.03 OF THE LATEST EDITION OF MUTCD — SHSM R15-1 • SIZE = 36"x36"x36" — SHSM R1-2 ENLARGED VIEW BELOW — SHSM I-13		E 190
1206+05, LT ~~1205+96, LT~~	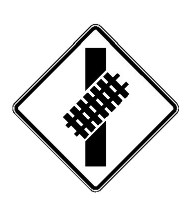	1	36	36	9.00						1					16.75 X		X															SHSM W10-12		
1207+99, LT	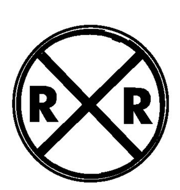	1	36	36	7.07						1					14.00 X		X															SHSM W10-1		E 190
												FT	FT	FT	FT	FT 121.50 ~~140~~	FT		EA	LB	LB	LB		LB	LB	LB	LB								
	TOTALS				SF 53.82	SF	EA.	SF				FT			FT 121.50 ~~140~~					LB			EA.	LB				EA.	EA.	LB					

FINAL POST LENGTHS ARE TO BE DETERMINED IN THE FIELD. POST SIZES ARE COMPUTED BASED ON INFORMATION FURNISHED ON THE STANDARD SHEETS AND THE TRAFFIC & SAFETY DIVISION'S "SIGN POST DESIGN GUIDELINE."

BOW = BLACK LEGEND ON WHITE BACKGROUND - PLAQUE
GOW = GREEN LEGEND ON WHITE BACKGROUND - PLAQUE
WOB = WHITE LEGEND ON BLUE BACKGROUND - PLAQUE
FYG = BLACK LEGEND ON FLUORESCENT YELLOW-GREEN BACKGROUND
SHSM = FHWA STANDARD HIGHWAY SIGNS AND MARKINGS BOOK (WITH 2012 SUPPLEMENT)

POST LENGTH AVERAGES 15 FEET
POST LENGTH WITH '+' AVERAGES 20 FEET

REPORT EMERGENCY
OR PROBLEM
TO 1-888-265-2735
CROSSING 837 359 T

EMERGENCY NOTIFICATION SIGN
NOT TO SCALE

NOTE
SIGN SHALL CONFORM TO THE LATEST EDITIONS OF THE SHSM FOR SIGN I-13

PROJECT NAME:	BARRE CITY - BARRE TOWN		
PROJECT NUMBER:	MEGC M 6000(11)C/1		
FILE NAME:	z15d040tss.dgn	PLOT DATE:	12/2/2016
PROJECT LEADER:	A.P. GUYETTE	DRAWN BY:	E.B. PARIZO
DESIGNED BY:	E.B. PARIZO	CHECKED BY:	D.M. PECK
TRAFFIC SIGN SUMMARY SHEET		SHEET	17 OF 39

The following product(s) are not active
ProjectWise InterPlot Server