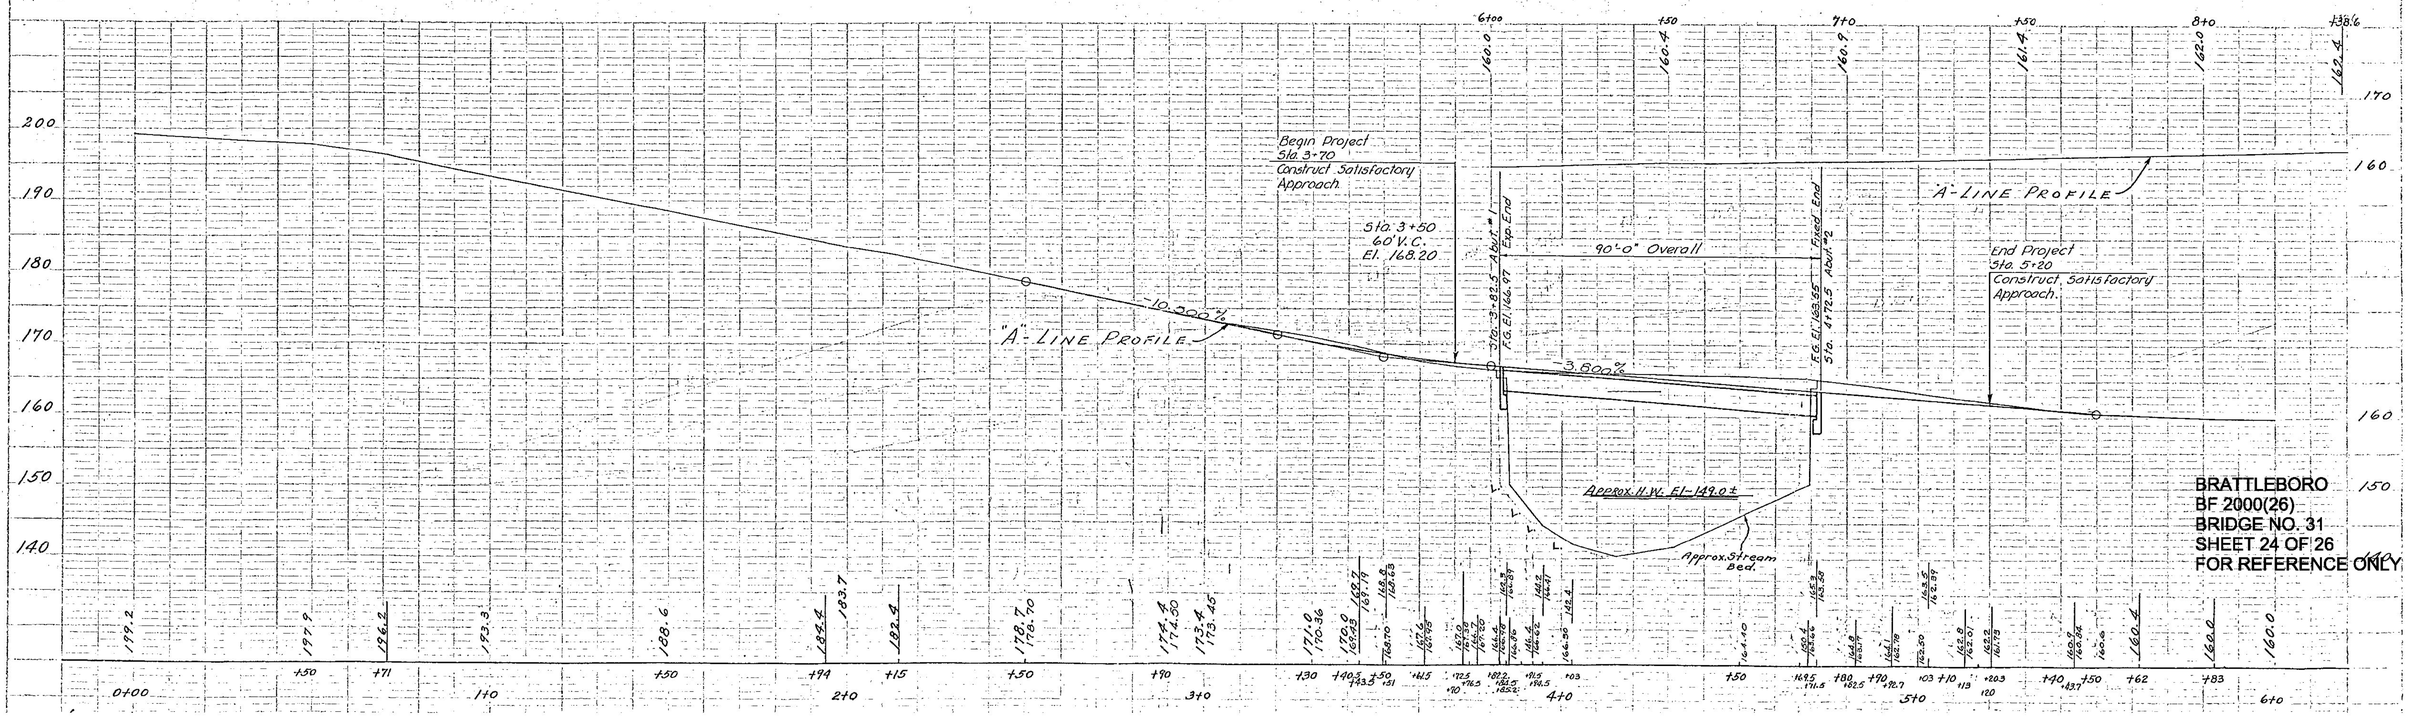

BRATTLEBORO
BF 2000(26)
BRIDGE NO. 31
SHEET 24 OF 26
FOR REFERENCE ONLY