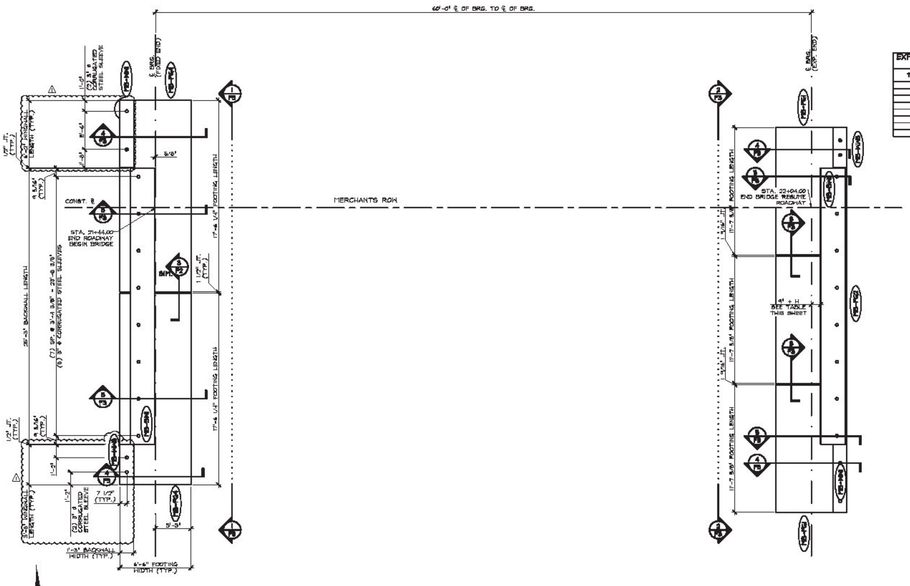
60'-0" ℄ OF BRG. TO ℄ OF BRG.
MERCHANTS ROW
END ROADWAY
END BRIDGE ROADWAY
EXPANSION GAP
(0.75" FOAM)
(0.75" FOAMED-IN-PLACE)
