
℄



5+00

500 500

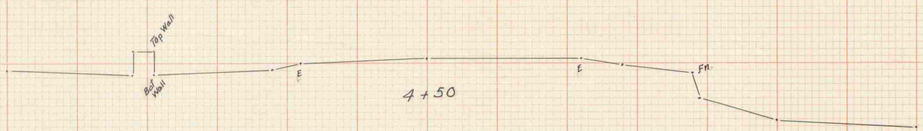

4+50

495 495



4+00

495 495



3+80

495 495



3+50

495 495

℄

TOWNSHEND – S.A. 17/1953
SIMPSONVILLE BRIDGE

ROADWAY SECTIONS

Scale 1" = 5'

LEVELS BY POGAR
SECTIONS PLOTTED BY D.W.P CKD. BY H.R.C.
PLANIMETERED BY M.L.J CKD. BY R.B.M
EXAMINED BY
TOWNSHEND NO S.A.17/53 FILED
SHEET 9 OF 10

TRADE STANDARD MARK
SER. E.S. PAT. OFF.
CROSS SECTION 10 X 10
100 % RAG PAPER
MADE IN U.S.A.

KEUFFEL & ESSER CO.
NEW YORK