PLATE 3 CROSS SECTION O.P.R.R. STANDARD
RETAINER CURRENTATION

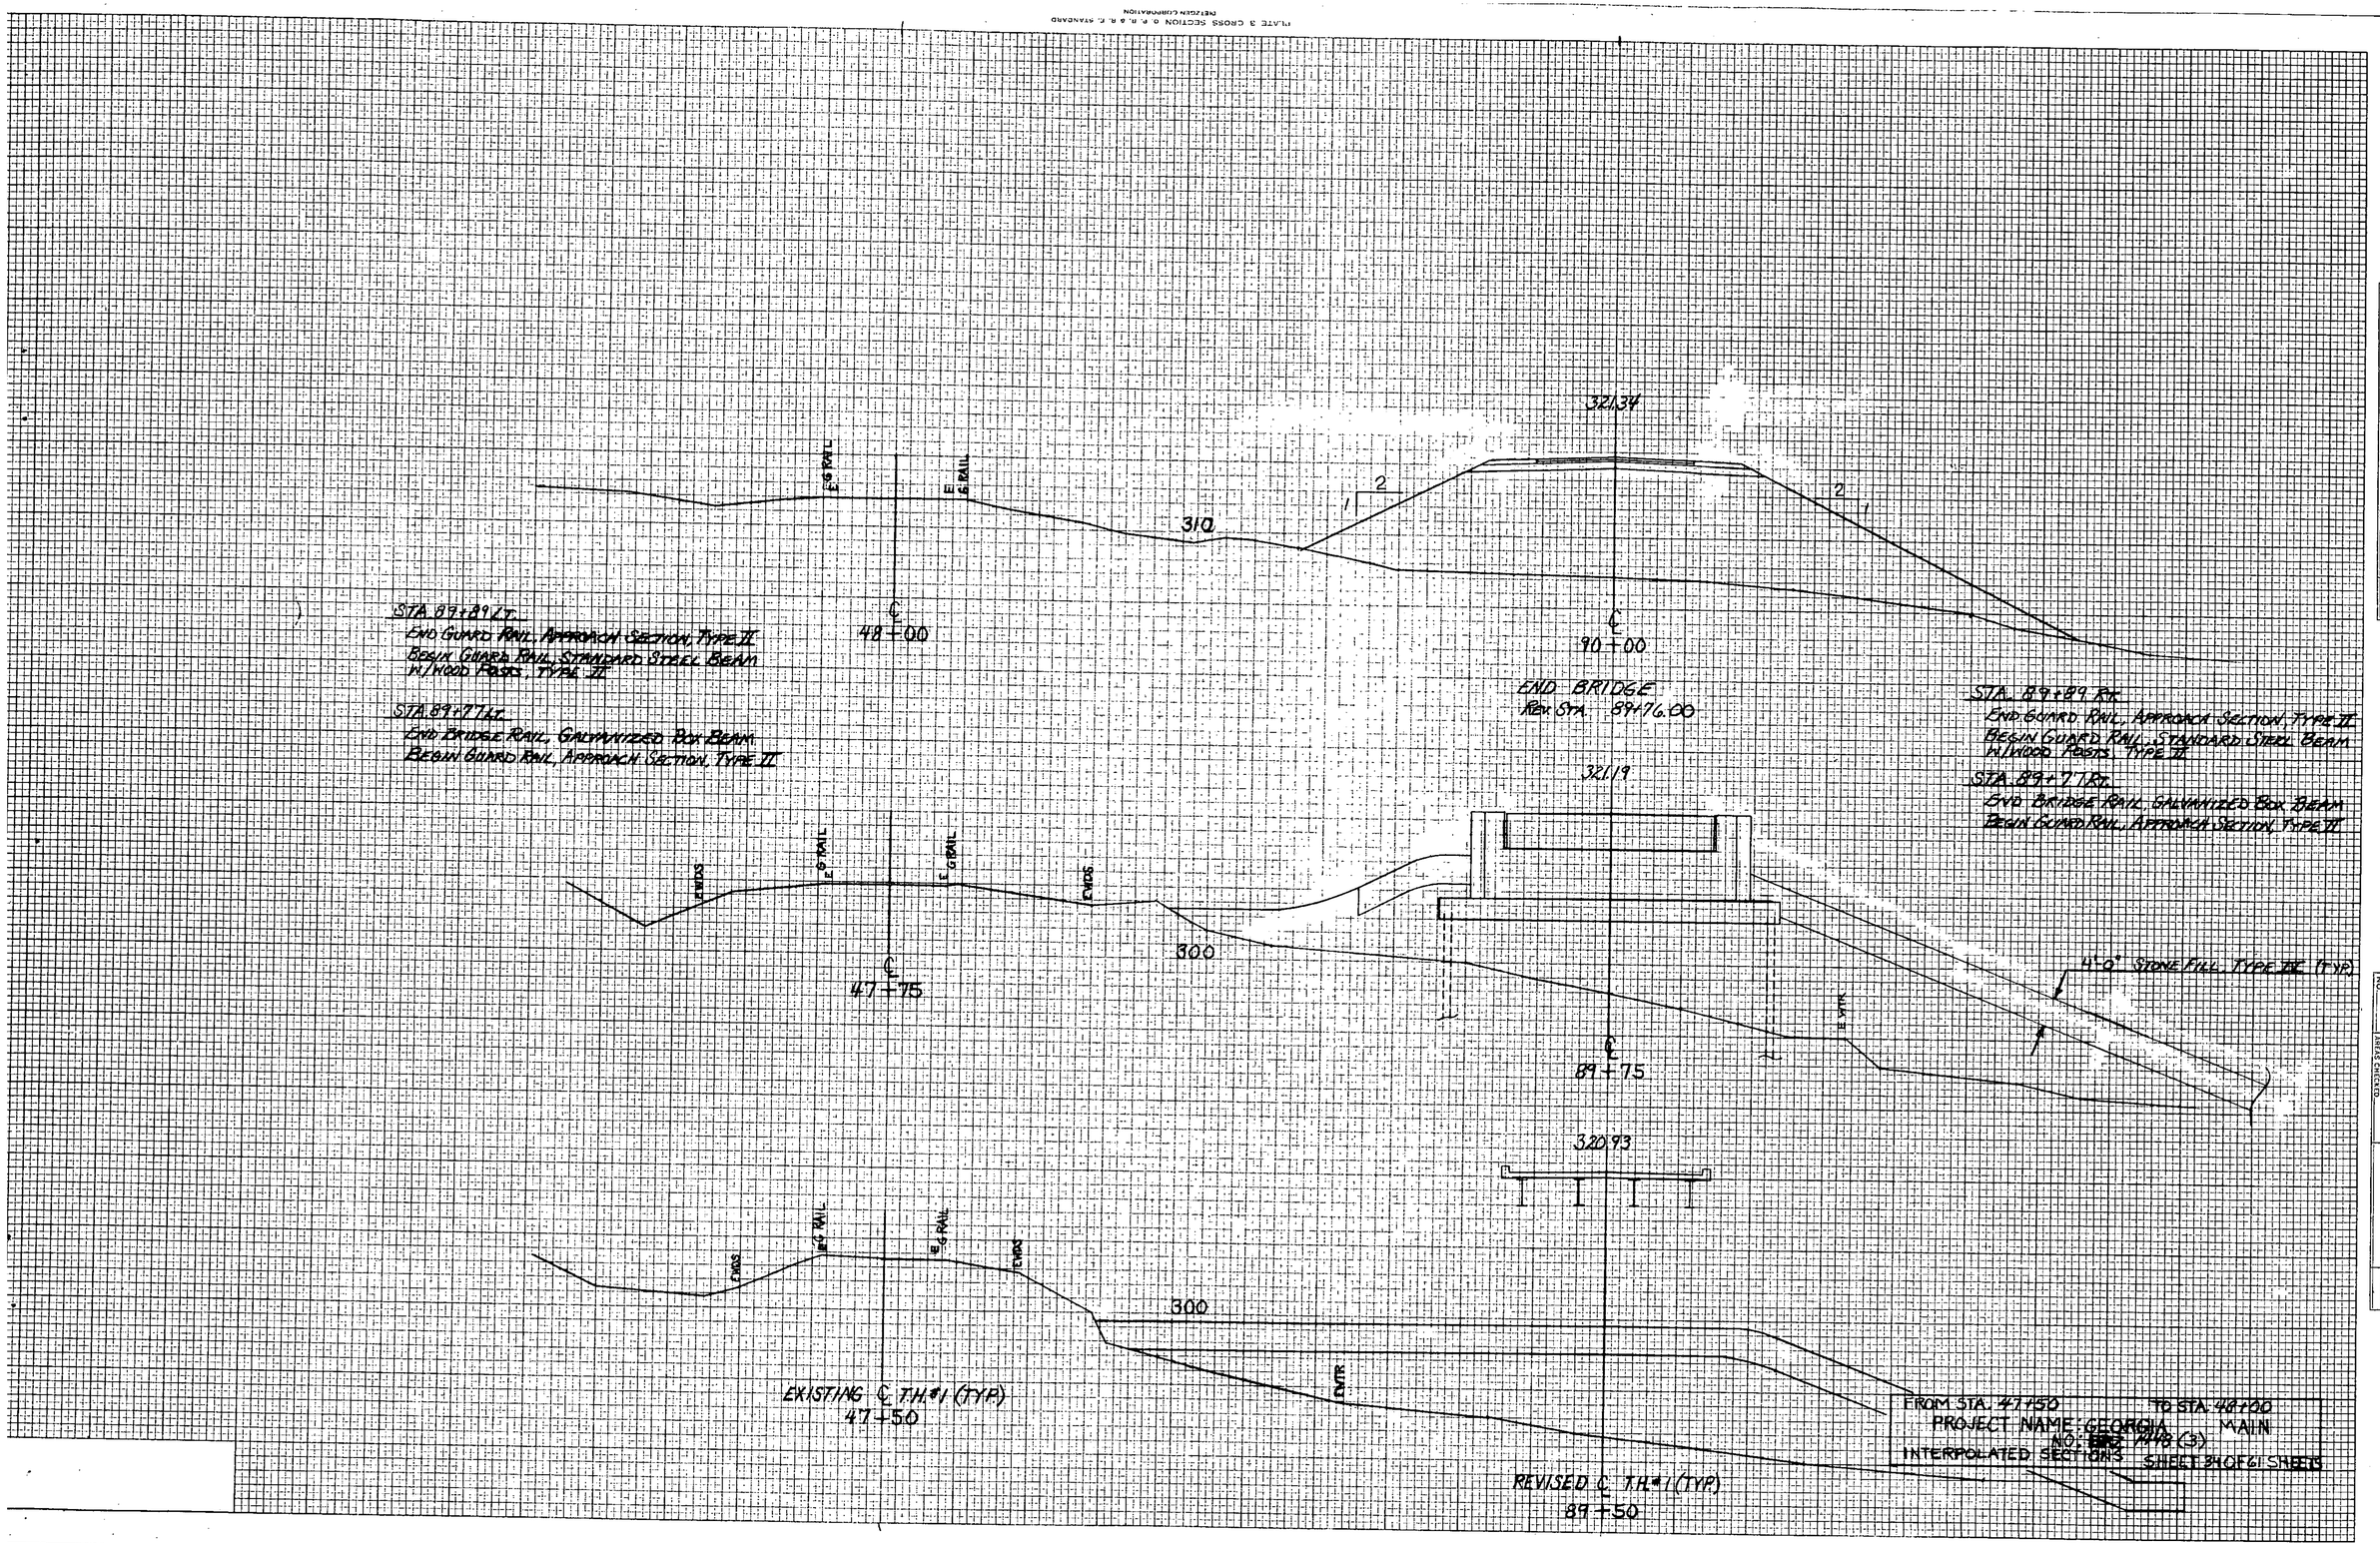

FROM STA. 47+50 TO STA. 48+00
PROJECT NAME: GEORGIA MAIN
NO: [redacted] 7478 (3)
INTERPOLATED SECTIONS SHEET 34 OF 61 SHEETS

ORIGINAL SURVEY			BY	DATE
NOTE BOOK	SURVEYED			
NO.	PLOTTED			
	TEMPLATE			
	AREAS			
	AREAS CHECKED			

FINAL SURVEY			BY	DATE
NOTE BOOK	SURVEYED			
NO.	PLOTTED			
	TEMPLATE			
	AREAS			
	AREAS CHECKED			