


BRUNING 44 131 42916

ORIGINAL SURVEY	NO. _____	DATE _____
NOT BOOK	NO. _____	DATE _____
AREA CHECKED	NO. _____	DATE _____

FINAL SURVEY	NO. _____	DATE _____
NOT BOOK	NO. _____	DATE _____
AREA CHECKED	NO. _____	DATE _____

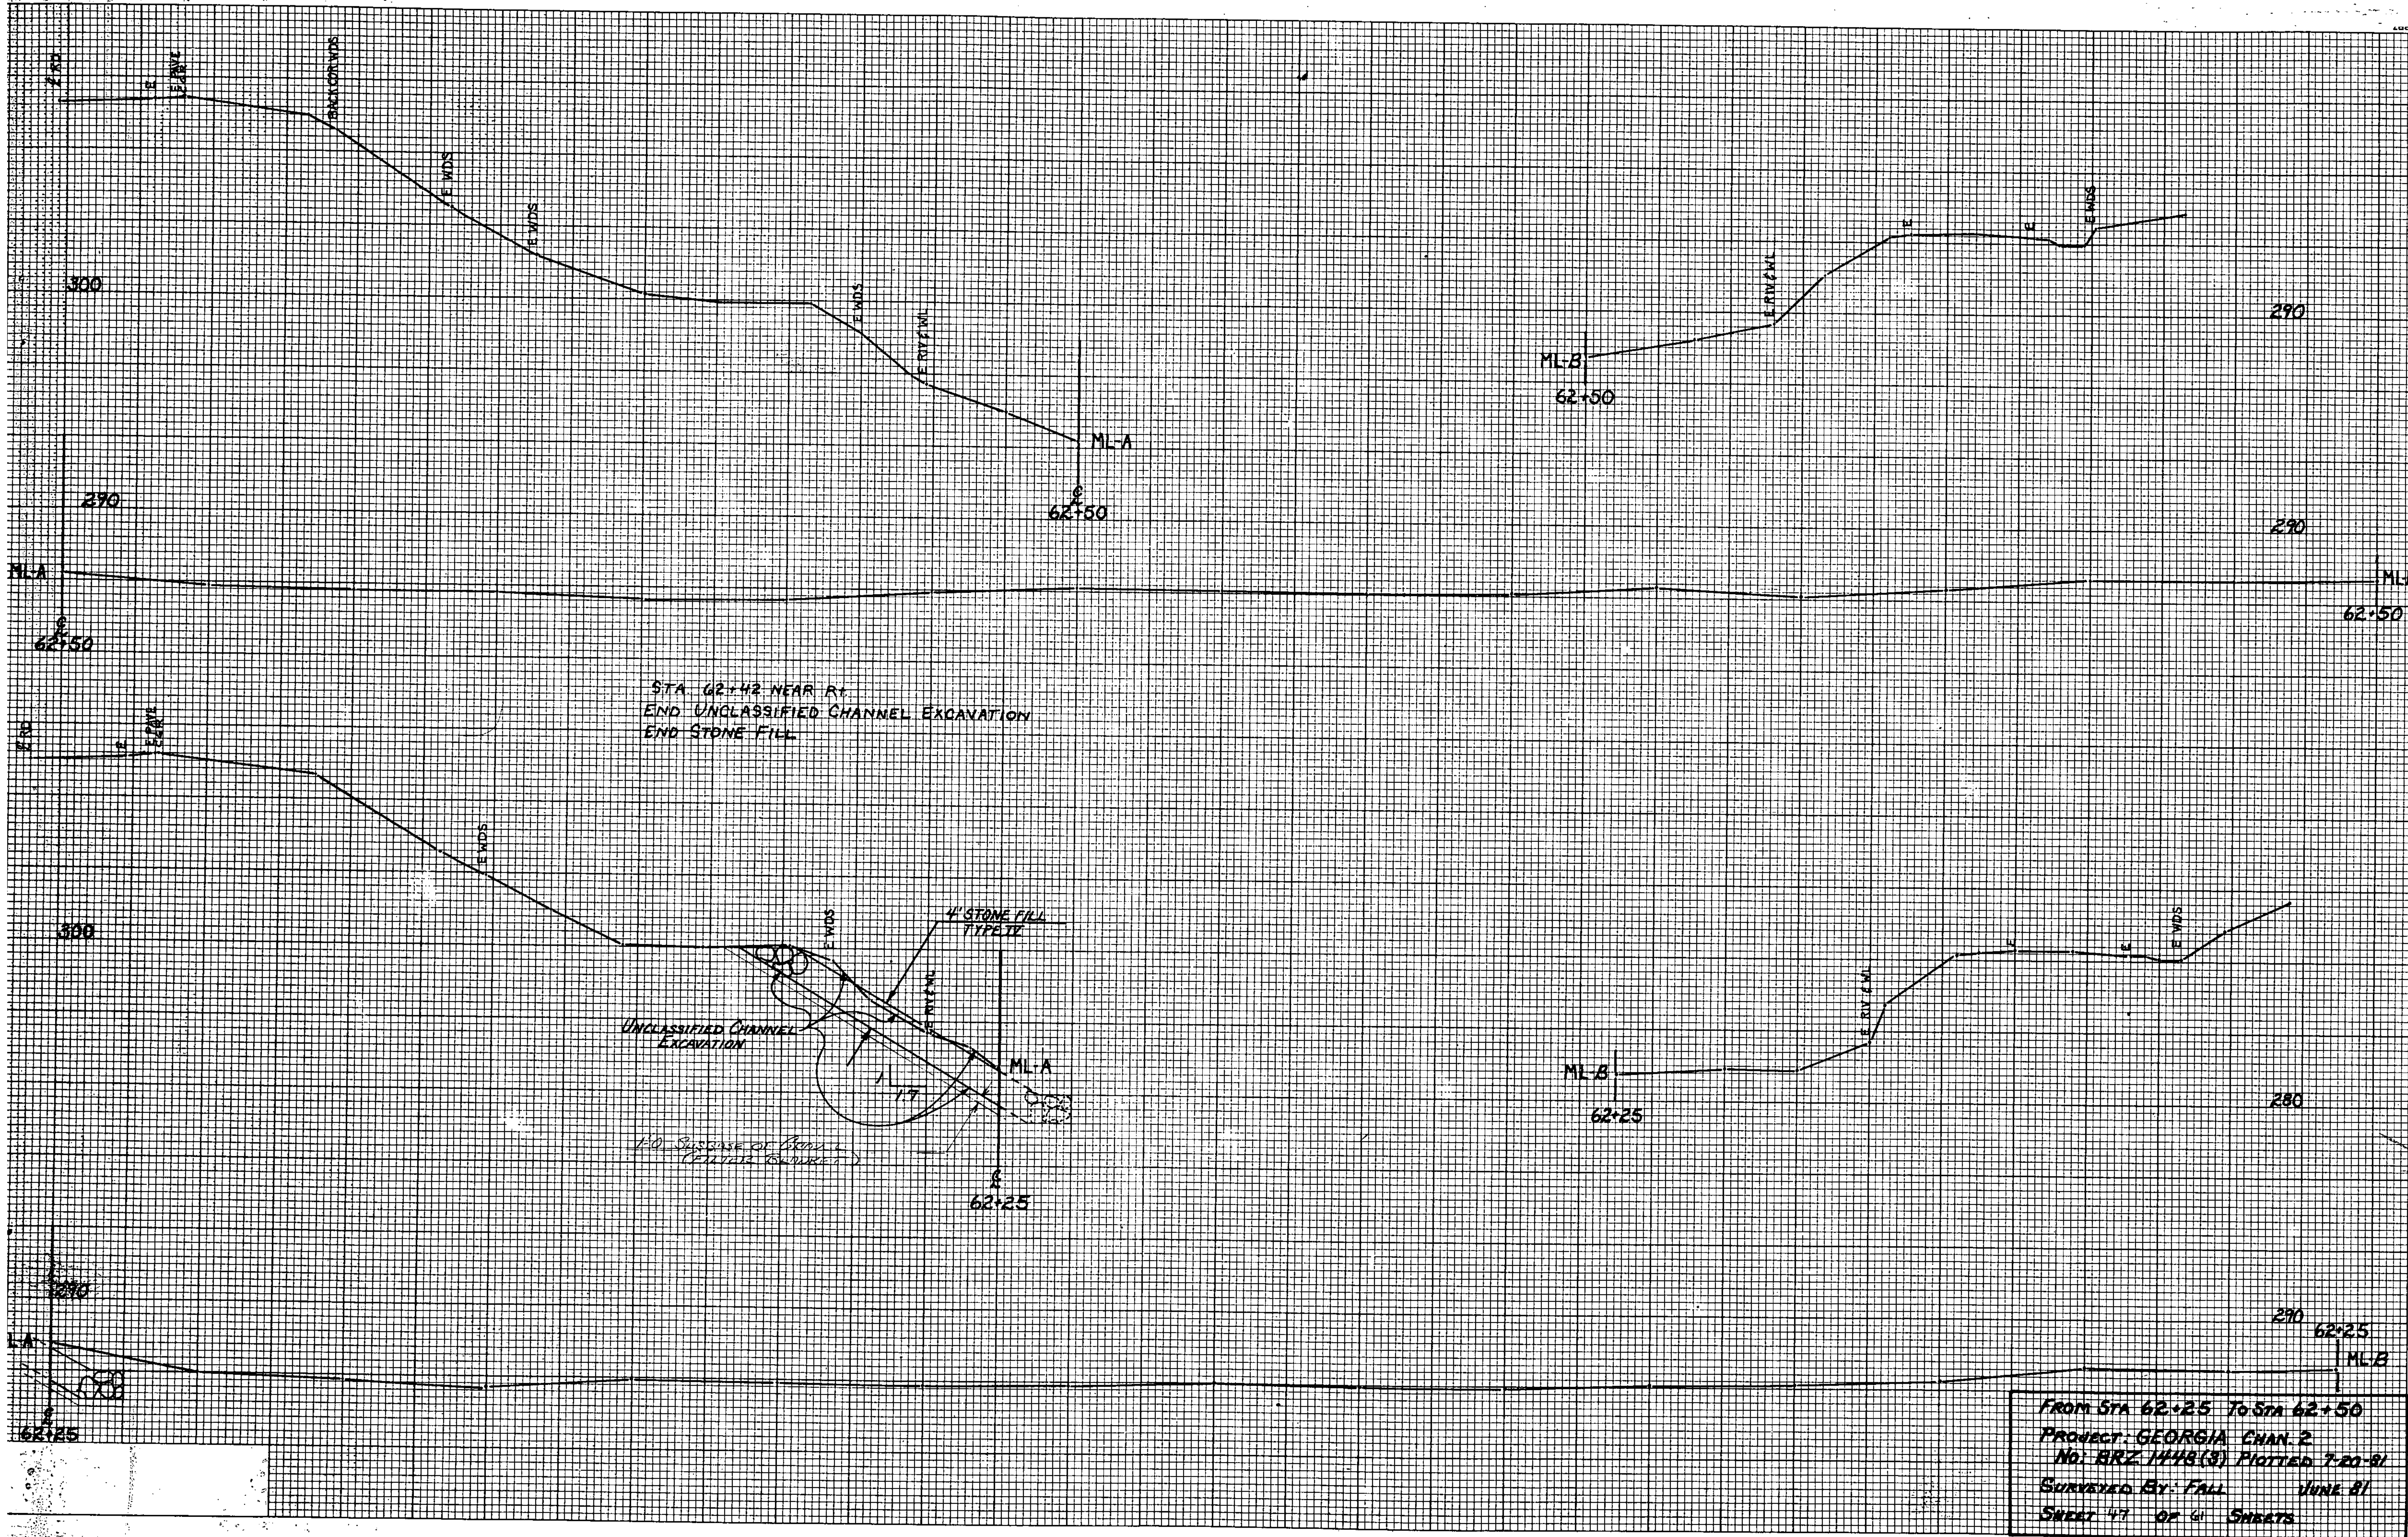

STA 62+42 NEAR RT.  
END UNCLASSIFIED CHANNEL EXCAVATION  
END STONE FILL

UNCLASSIFIED CHANNEL EXCAVATION  
4' STONE FILL TYPE IV  
1.0 SLOPE OF BANK (SEE PLAN SHEET)

From STA 62+25 To Sta 62+50  
PROJECT: GEORGIA CHAN. 2  
No. BRZ 1448(3) PLOTTED 7-20-81  
SURVEYED BY: FALL JUNE 81  
SHEET 47 OF 61 SHEETS