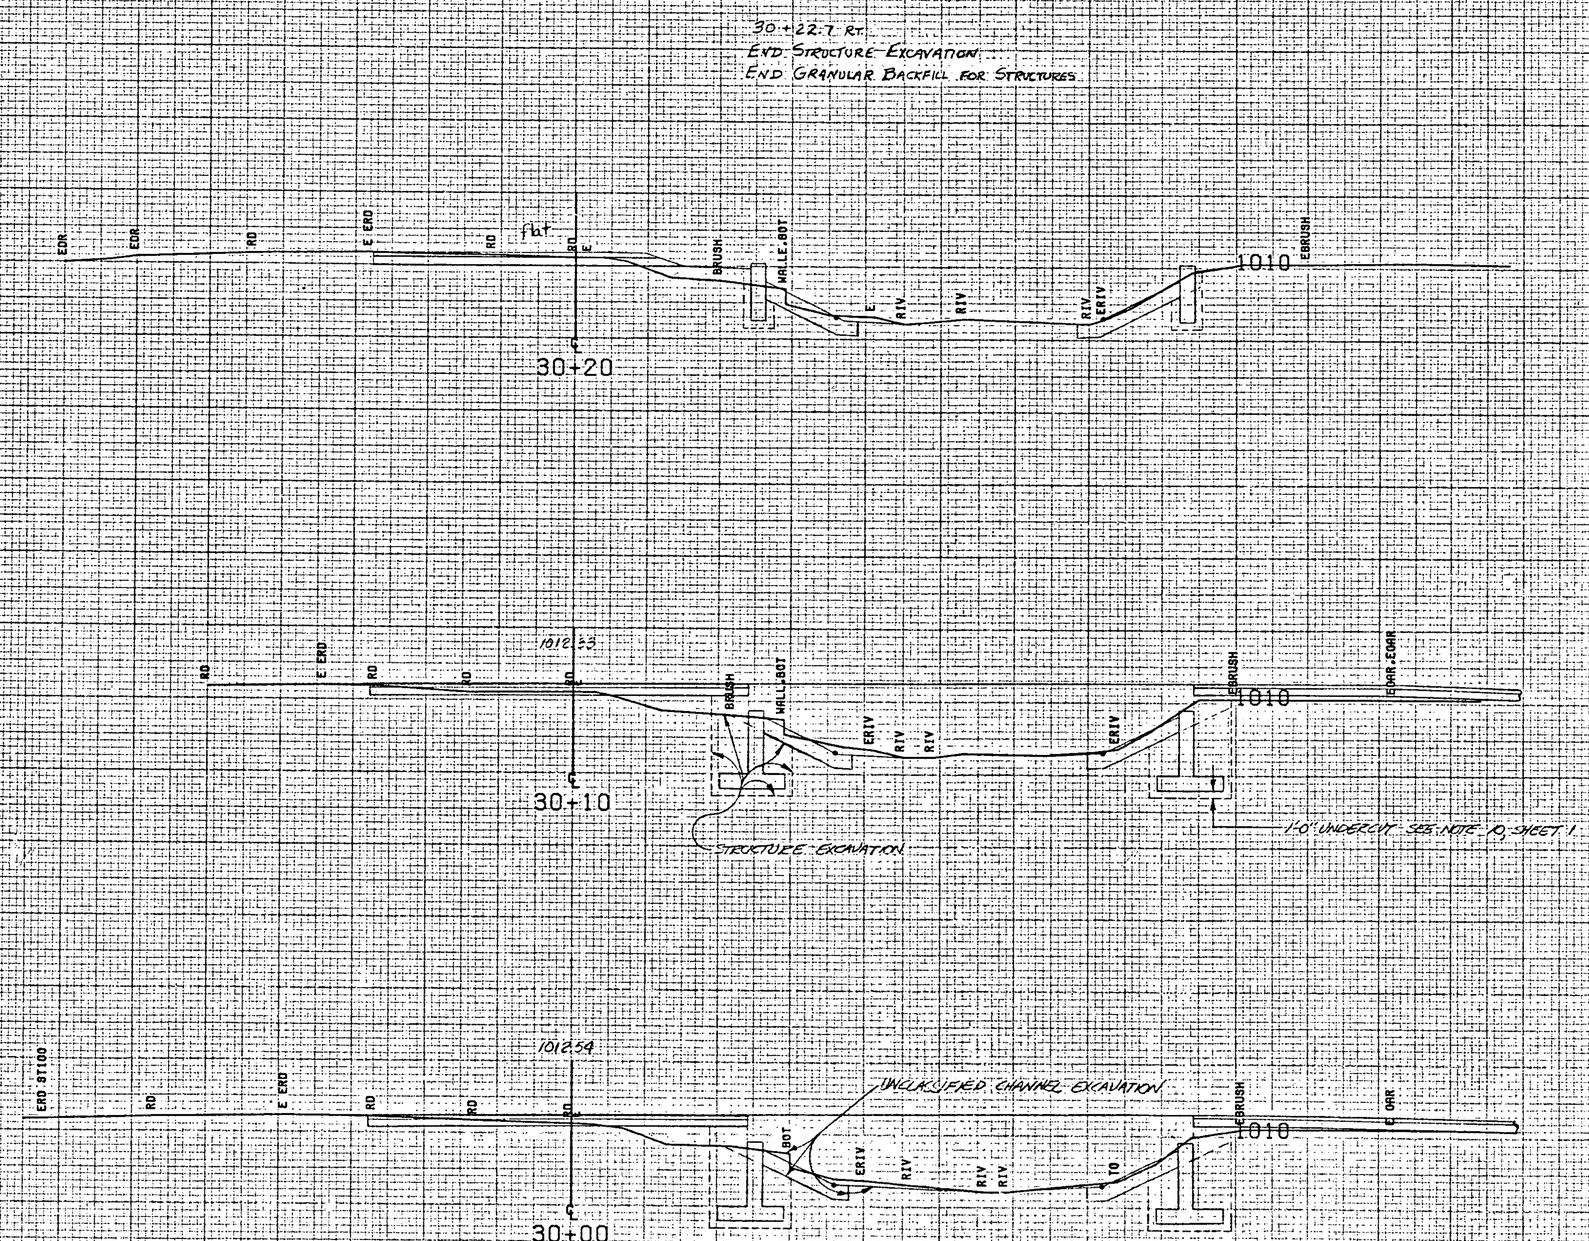

FROM STA. 30+00		TO STA. 30+20	
PROJECT NAME	GRANVILLE TH4		
NO.	BRZ1444(9)		PLOTTED 11/16/82
SURVEYED BY	FANTONI		JUNE 1982
SHEET 25 OF 111 SHEETS			

SCALE 10 FEET