


DATE: _____
 BY: _____
 PLAN
 NOTE BOOK
 NO. _____

DATE: _____
 BY: _____
 PROFILE
 NOTE BOOK
 NO. _____

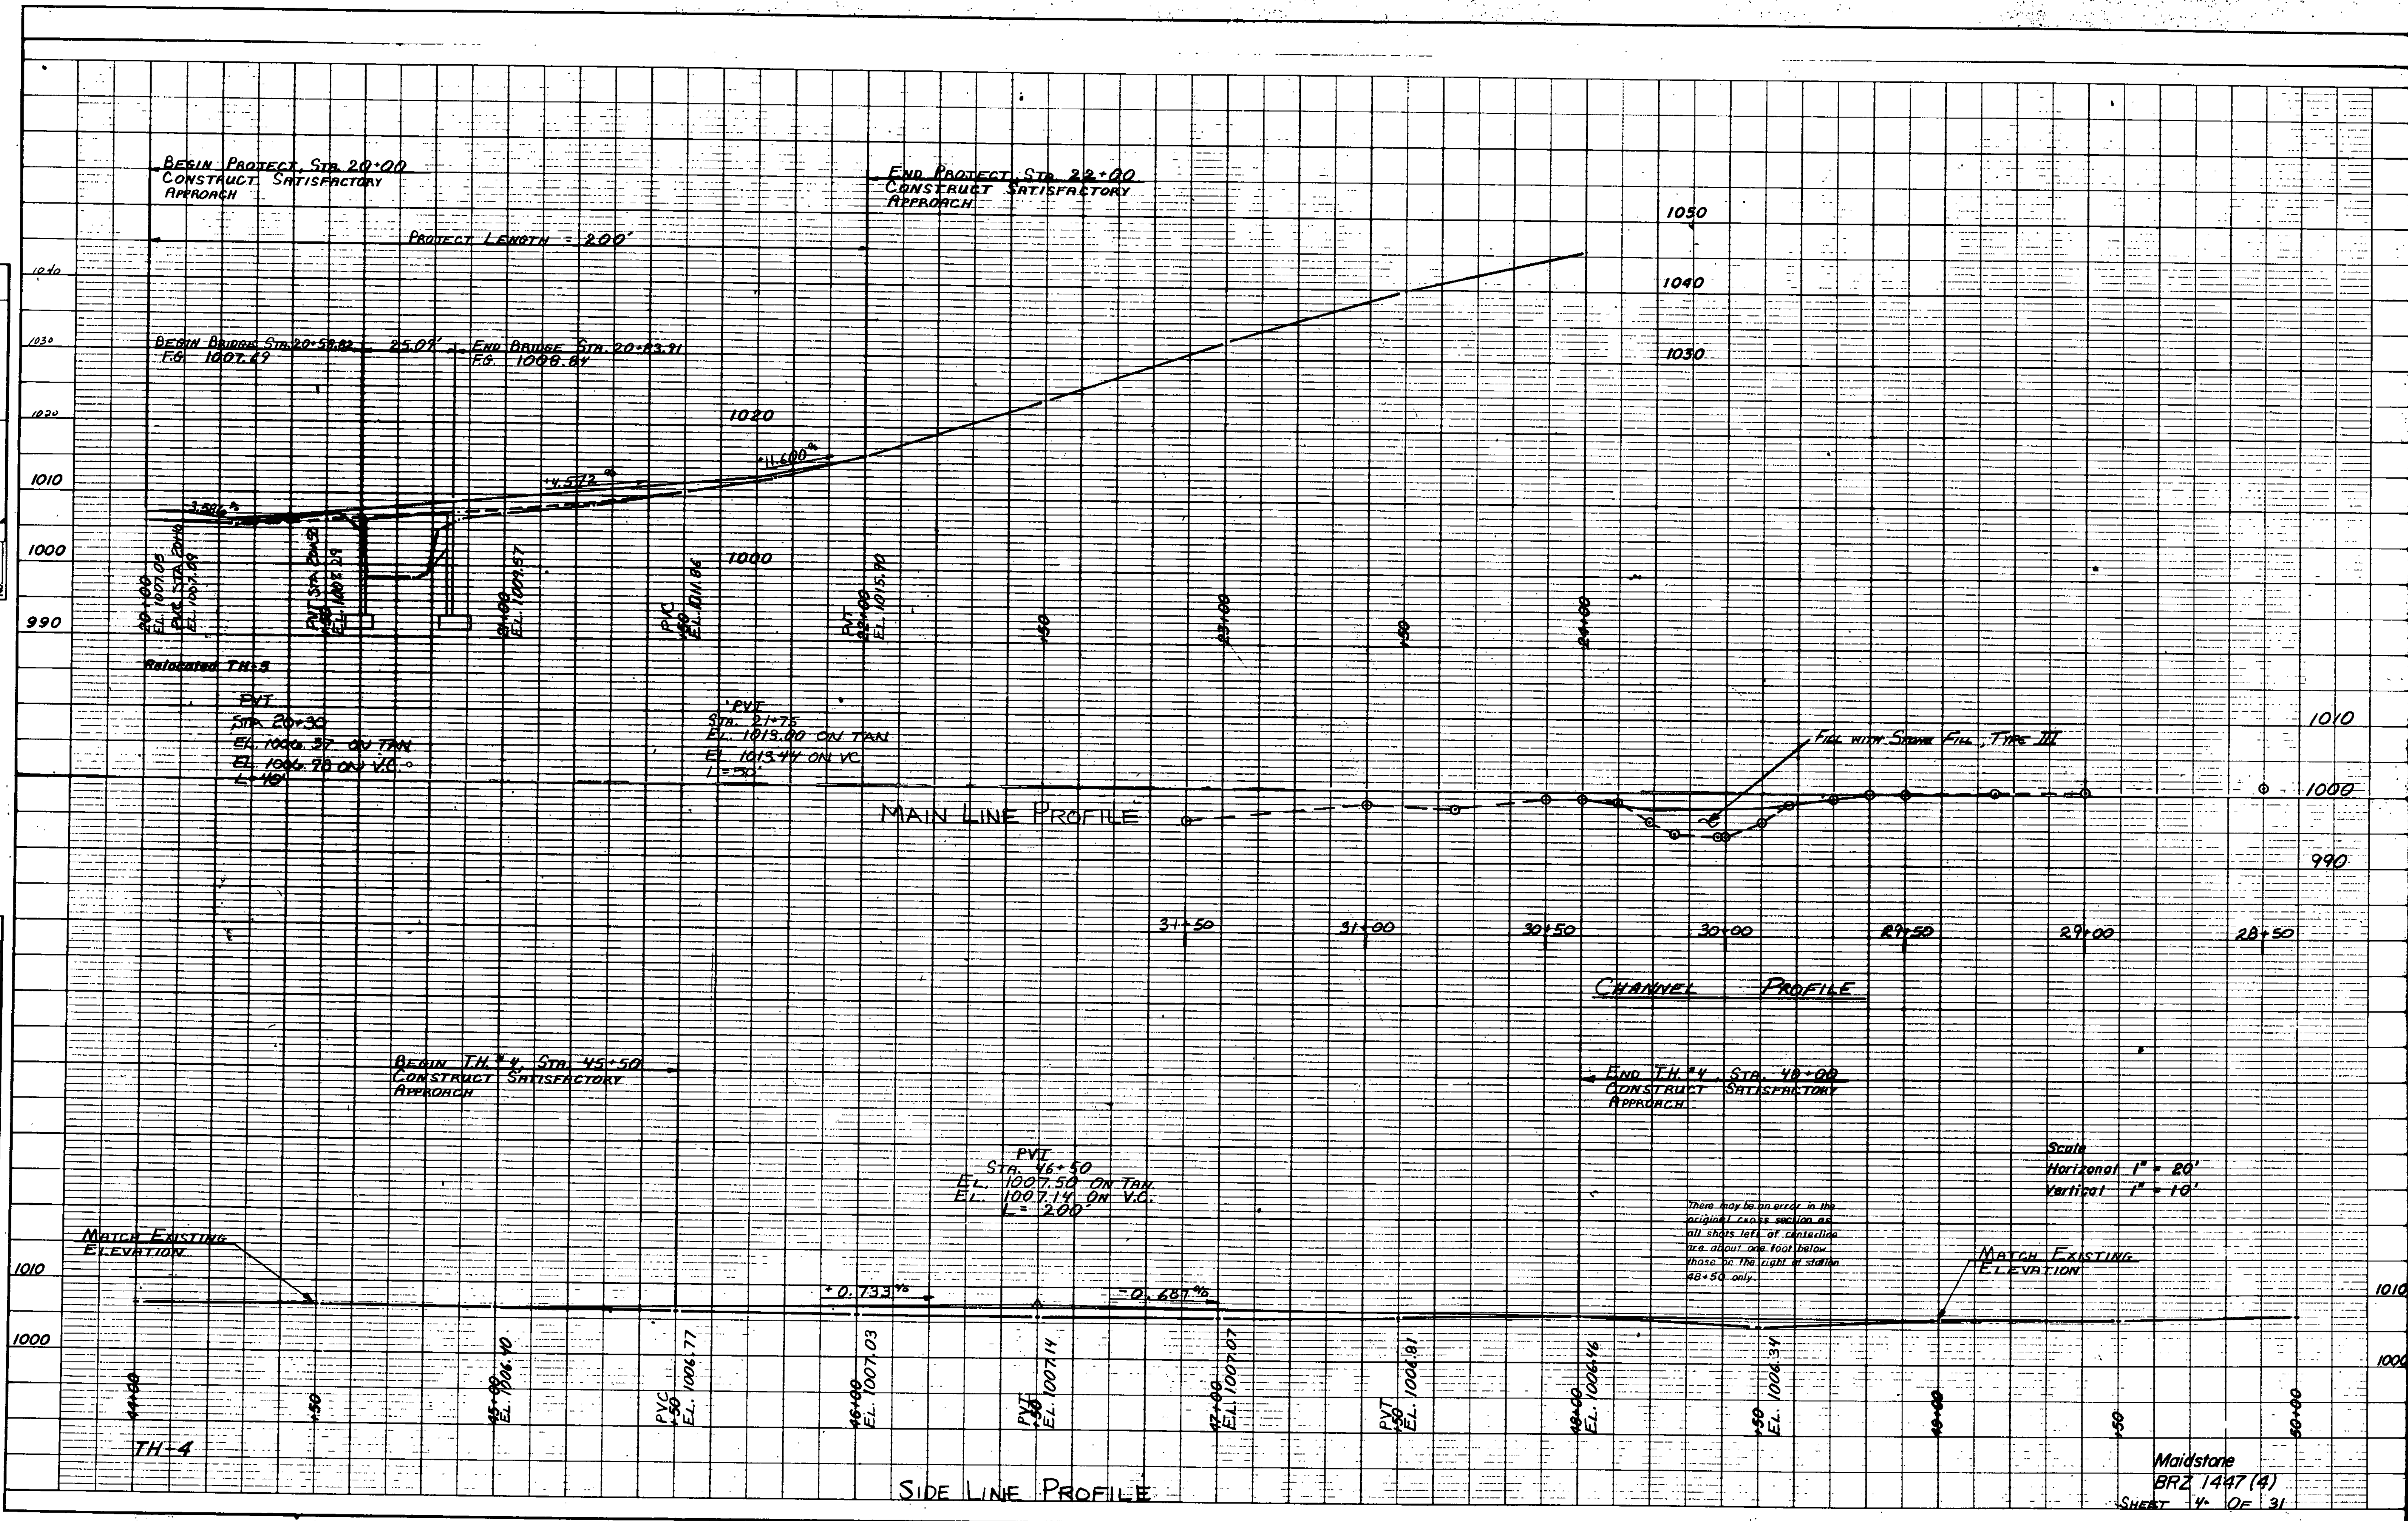

Maidstone
 BRZ 1447(4)
 SHEET 4 OF 31