Note (From survey notes)
Town of Maidstone's Road Commissioner told survey party, that in the spring of 1980, 1981 the brook backed up due to ice at present bridge site. Ice went down road leaving 3 foot [illegible] road.
Road Commissioner
Harold Nolle
Tel 676-[illegible] 12

Bridge Data

Single Span
I-Beam, plank deck
Log abutments
Roadway Length 24.7'±
Width 12'
Span 21'
Span 90° to abut 19'±
Clear spans
Upstream 8.5'
Downstream 10.5
I-Beams
4-8" x 4" x 28'
3-10" x 5" x 28'

BRIDGE RAILING, H.D. STEEL BEAM, TYPE C
STA. 20+54 ~ 20+84 LT.
STA 20+58 ~ 20+91 RT.

Relocated T.H. 5 Curve 1
Curve Data

Δ 39°-14' Rt.
D 28°
R 204.63'
T 72.93'
L 140.12'
E 12.61'
Banking

GUARD RAIL, H.D. STEEL BEAM WITH WOOD POST, TYPE II
STA. 20+29 ~ 20+54 LT.
STA. 20+84 ~ 21+14 LT.
STA. 20+41 ~ 20+58 RT.
STA. 20+91 ~ 21+50 RT.

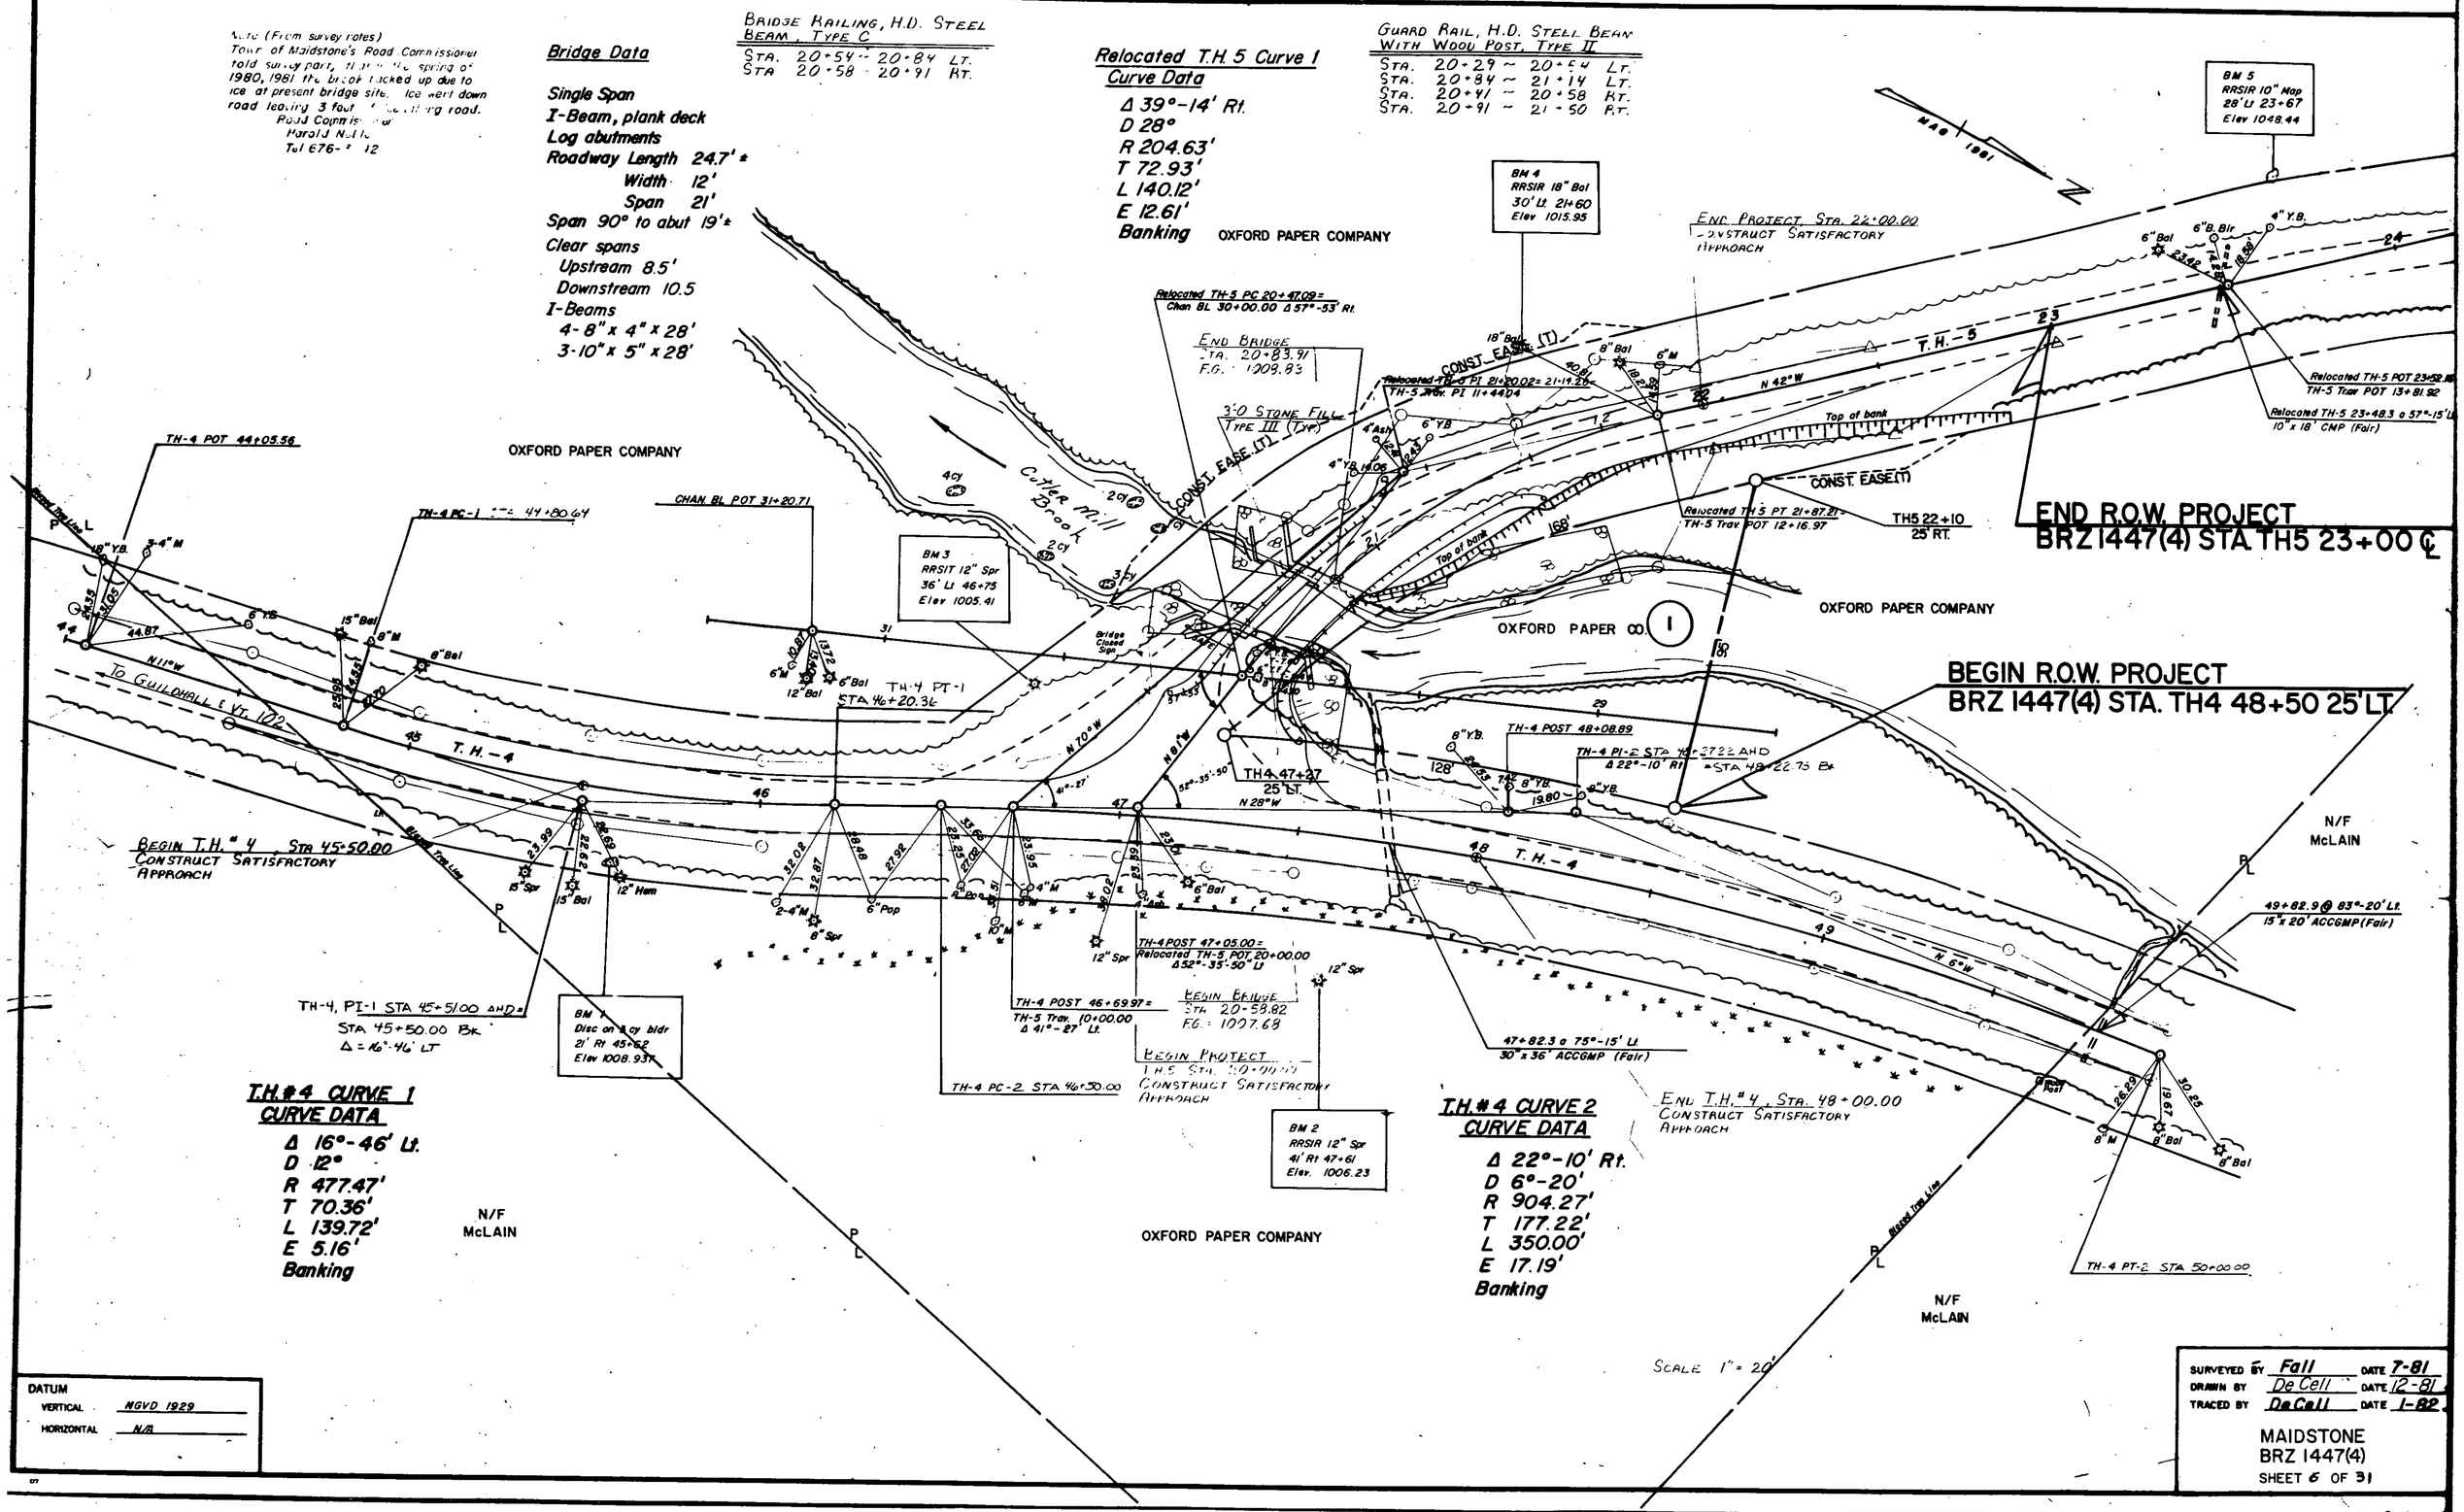

DATUM	
VERTICAL	NGVD 1929
HORIZONTAL	N/A

SURVEYED BY Fall DATE 7-81
DRAWN BY DeCell DATE 12-81
TRACED BY DeCell DATE 1-82

MAIDSTONE
BRZ 1447(4)
SHEET 6 OF 31