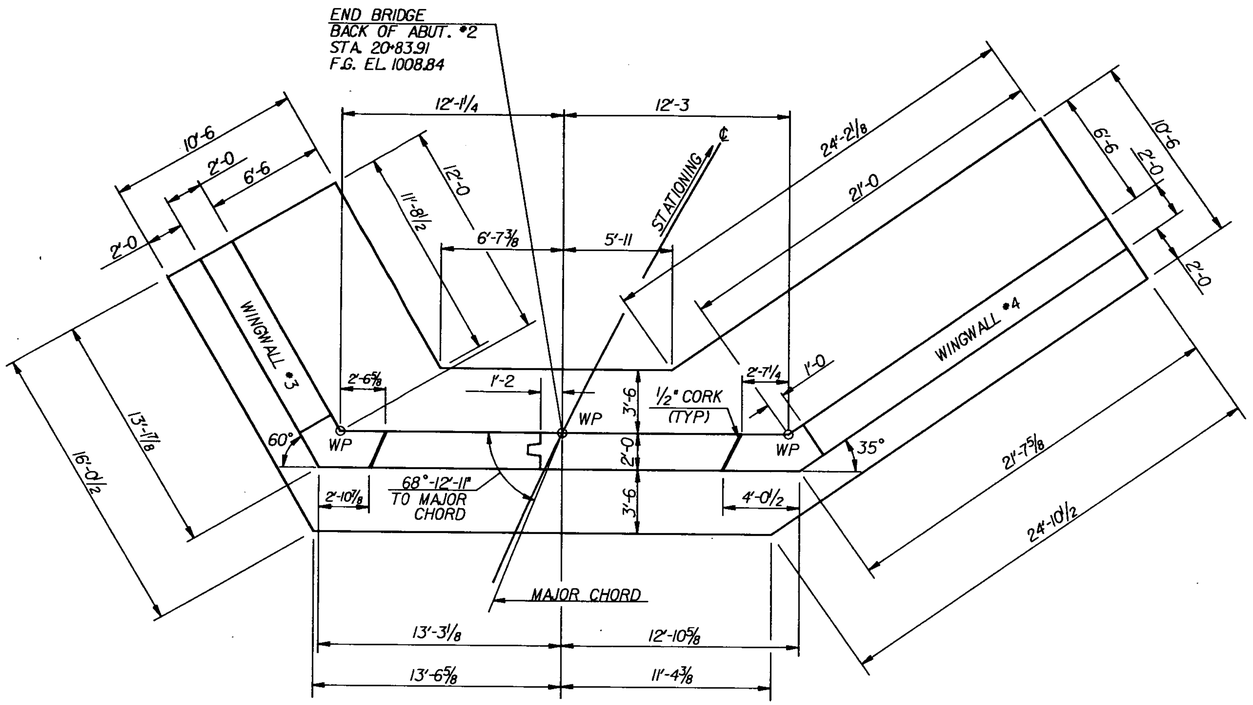

PLAN
SCALE 1/4" = 1'-0

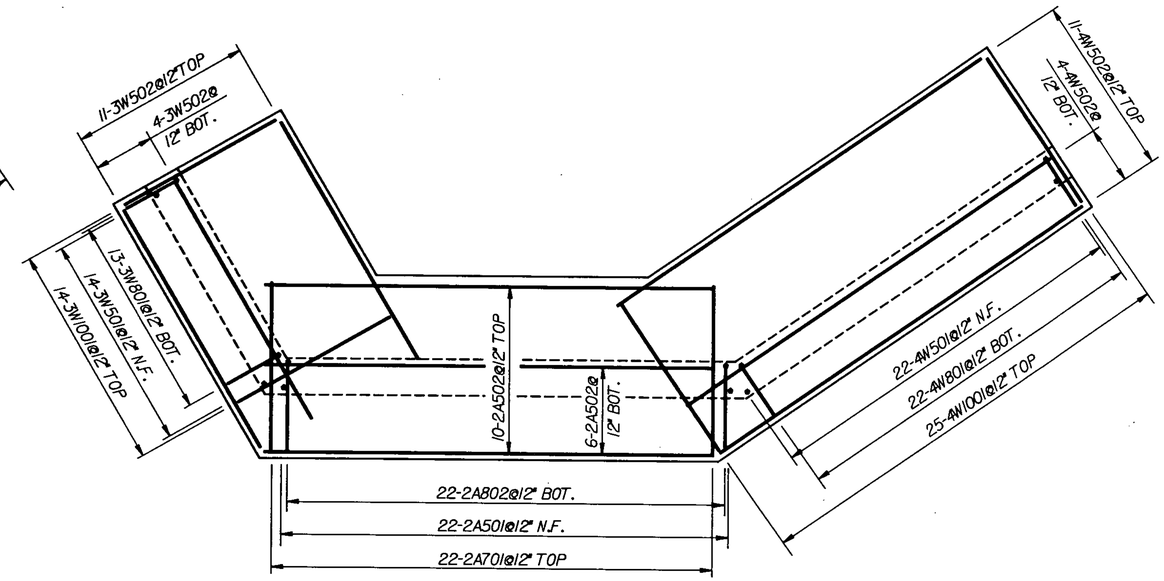

FOOTING REINFORCING PLAN
SCALE 1/4" = 1'-0

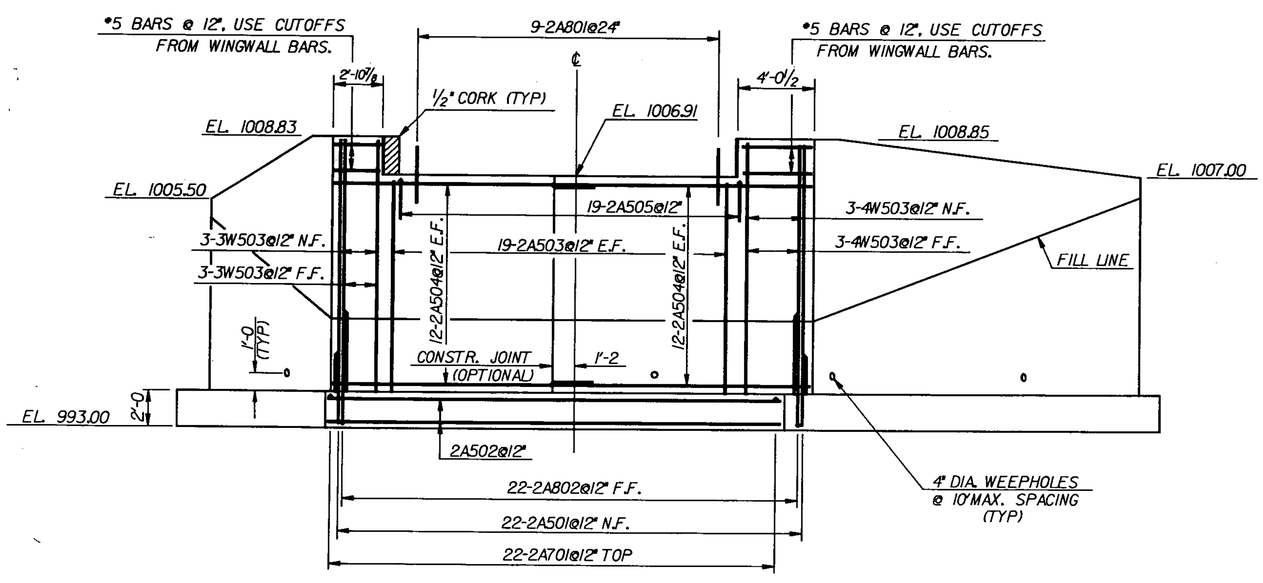

ELEVATION
SCALE 1/4" = 1'-0

STATE OF VERMONT
AGENCY OF TRANSPORTATION

Town Of MAIDSTONE	Bridge No. 6
Highway No. T.H. 5	Log Sta. / Surv. Sta. 20+70
ABUTMENT NO. 2 DETAILS	
T.H. 5 OVER DUTTON BROOK	
Designed By D.C. WILLEY	Drawn By D.C. WILLEY
Checked By A. ELWOOD Date 1-85	Bridge Design Supervisor R.S. HAUPT Date 6-84
PROJECT MAIDSTONE	PROJECT NO. BRZ 1447 (4)
L.G.C. Info. QSAI:[30.25]63C225AB2.DGN	
Bridge Sheet No.	Sheet 11 of 31

BR-6