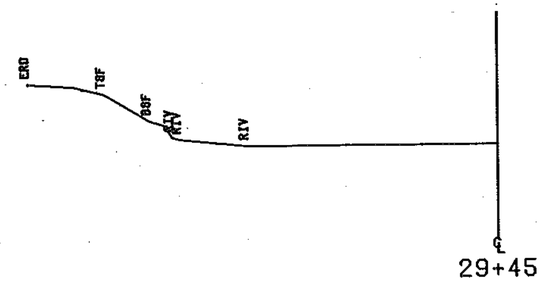

490

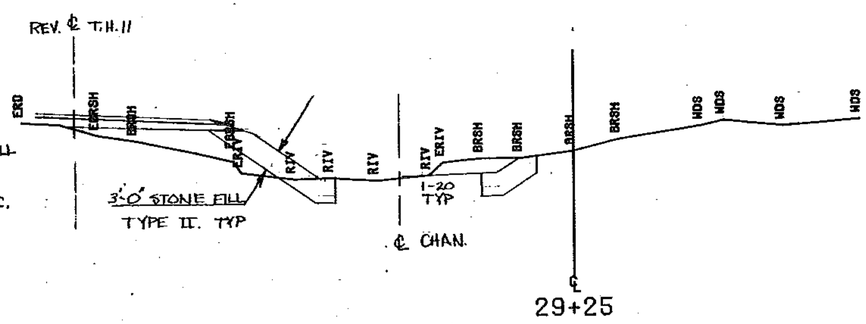

CHAN. STA. 29+28 LT. BEGIN. GRANULAR BACKFILL FOR STRUCTURE.

CHAN. STA. 29+25 LT. BEGIN. STRUCTURE EXC.

490

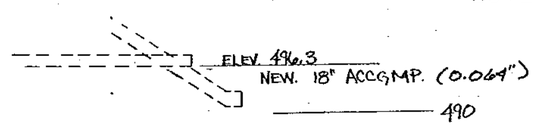

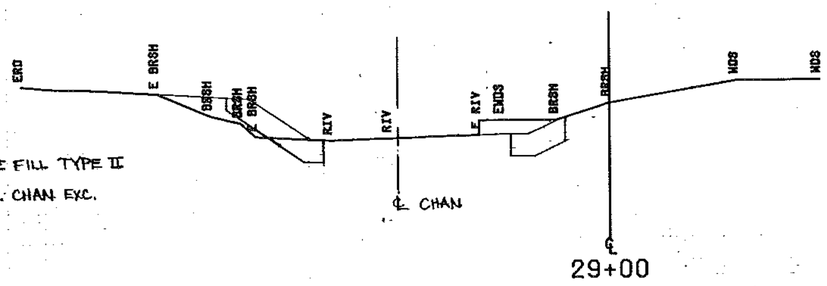

CHAN. STA. 28+75 LT BEGIN STONE FILL TYPE II

CHAN. STA. 28+75 LT. BEGIN UNCL. CHAN. EXC.

490

CHAN STA 28+75 RT BEGIN STONE FILL TYPE II

CHAN. STA 28+75 RT BEGIN UNCL. CHAN. EXC.

FROM STA. 29+00		TO STA. 29+45	
PROJECT NAME	CONCORD CHAN		
NO.	BRZ1447(10)		PLOTTED 11/15/82
SURVEYED BY	SARGENT		JANUARY 1982

SCALE: 10 FEET

SHEET 21 OF 29 SHEETS