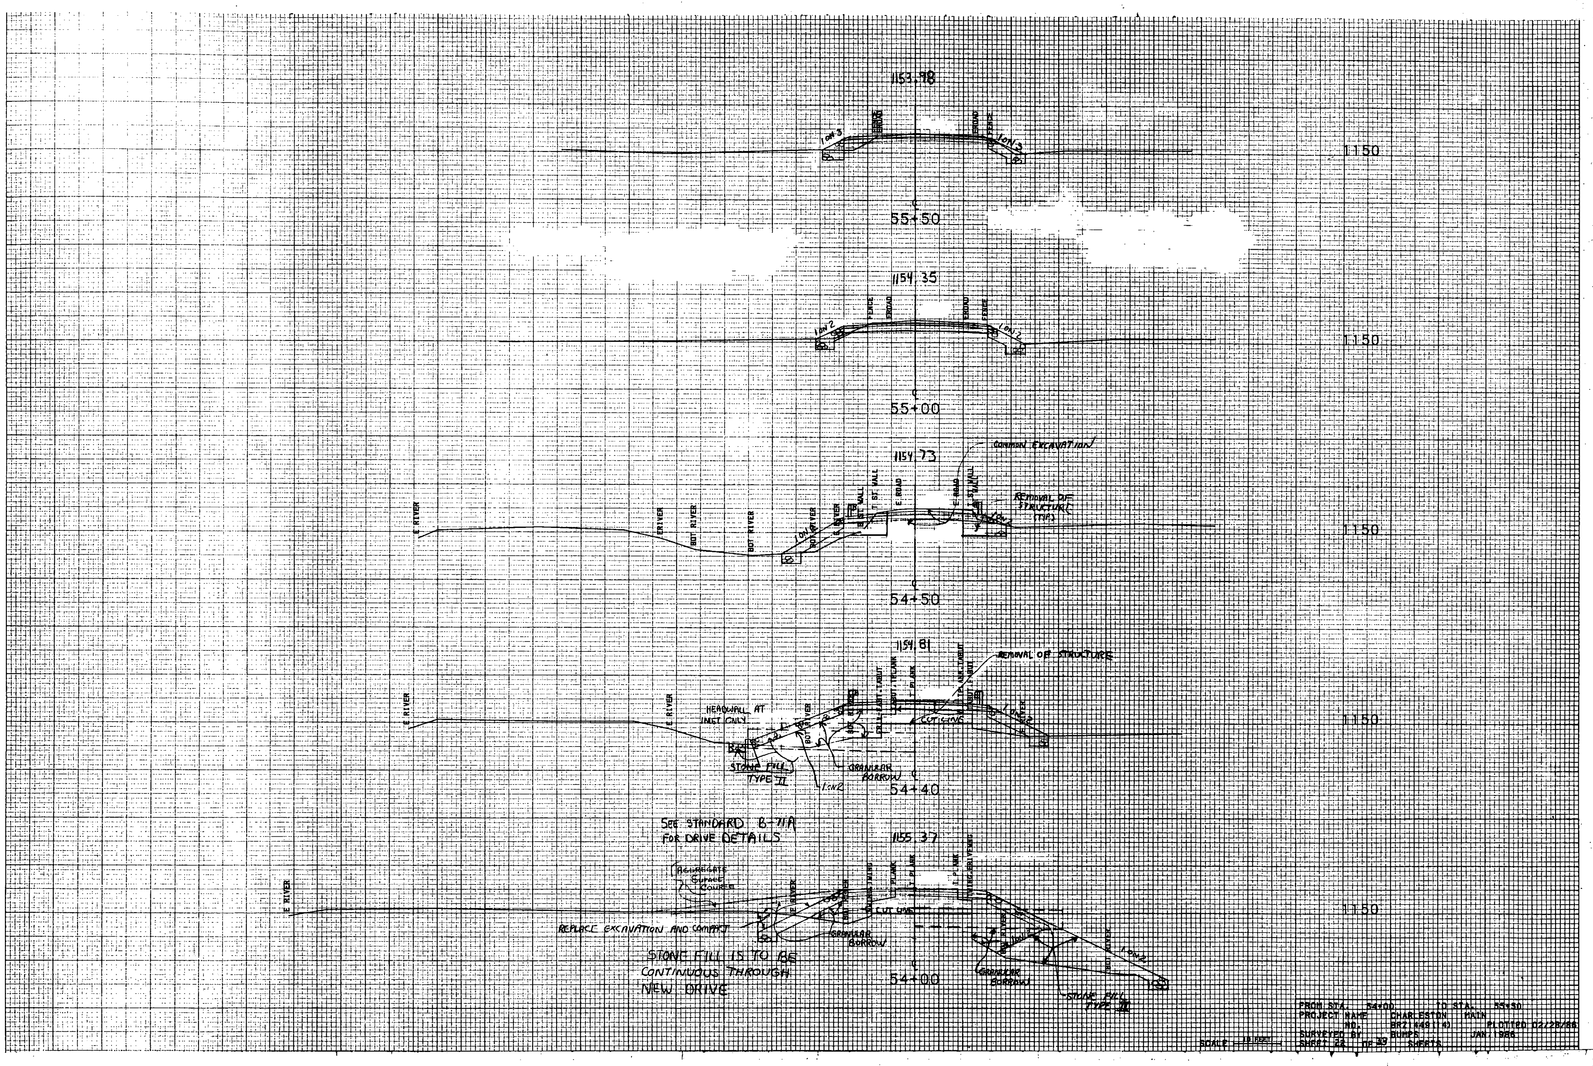
1153.78
55+50
1154.35
55+00
1154.73
54+50
1154.81
54+40
1155.37
54+00
1150
E. RIVER
HEADWALL AT INLET (ONLY)
STONE FILL TYPE II
1on2
See STANDARD 8-11A FOR DRIVE DETAILS
REPLACE EXCAVATION AND COMPACT
STONE FILL IS TO BE CONTINUOUS THROUGH NEW DRIVE
REMOVAL OF STRUCTURE
GRAVEL BARROW
PROJECT NAME: CHARLESTON
PROJECT NO.: BR21-46(1)N
SURVEYED BY: BURPS
SHEET: 32 OF 32
SCALE: 1:1000
DATE: 1986
PLOTTED: 02/28/86