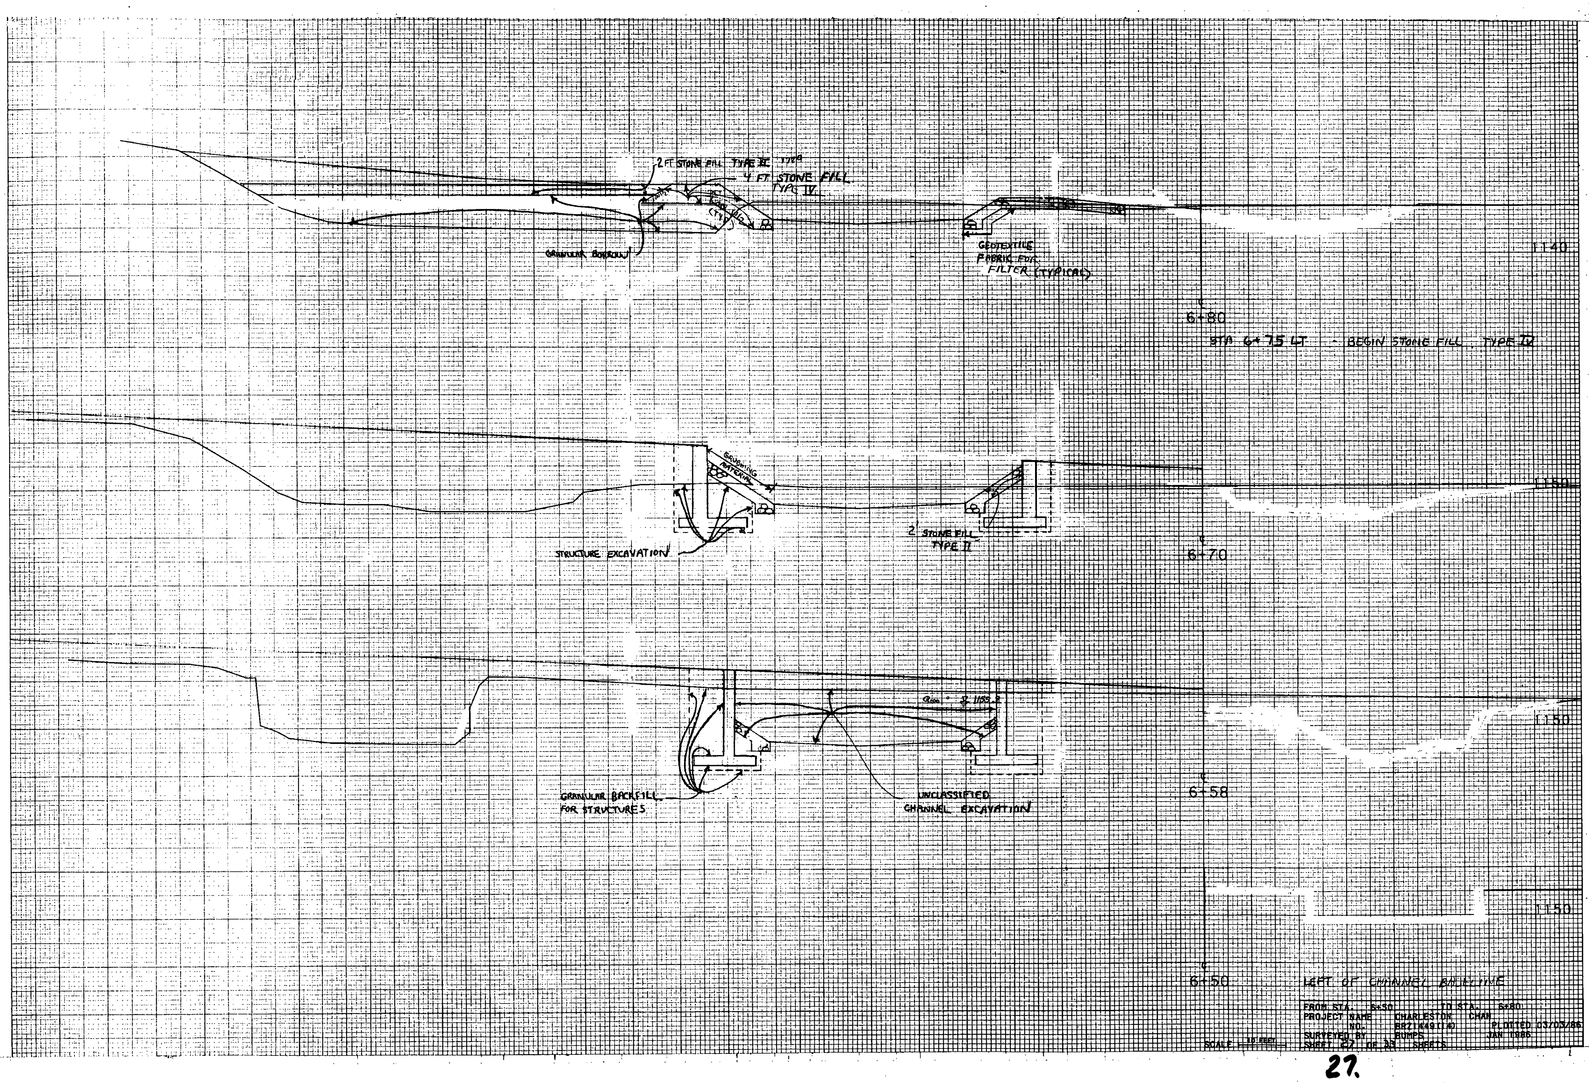
2 FT STONE FILL TYPE II
4 FT STONE FILL TYPE IV
GRANULAR BACKFILL
GEOTEXTILE FABRIC FOR FILTER (TYPICAL)
1140
6+80
STA 6+75 LT - BEGIN STONE FILL TYPE IV
STRUCTURE EXCAVATION
2 STONE FILL TYPE II
1130
6+70
1150
GRANULAR BACKFILL FOR STRUCTURES
UNCLASSIFIED CHANNEL EXCAVATION
6+58
1150
6+50
LEFT OF CHANNEL BREAKLINE
FROM STA 6+50 TO STA 6+80
PROJECT NAME CHARLESTON CHAN
NO. 8821 K4010
BRIDGE
PLOTTED 03/05/86
SUBMITTED BY
SHEET 27 OF 31 SHEETS
SCALE 1" = 10'