


BANKING DIAGRAM

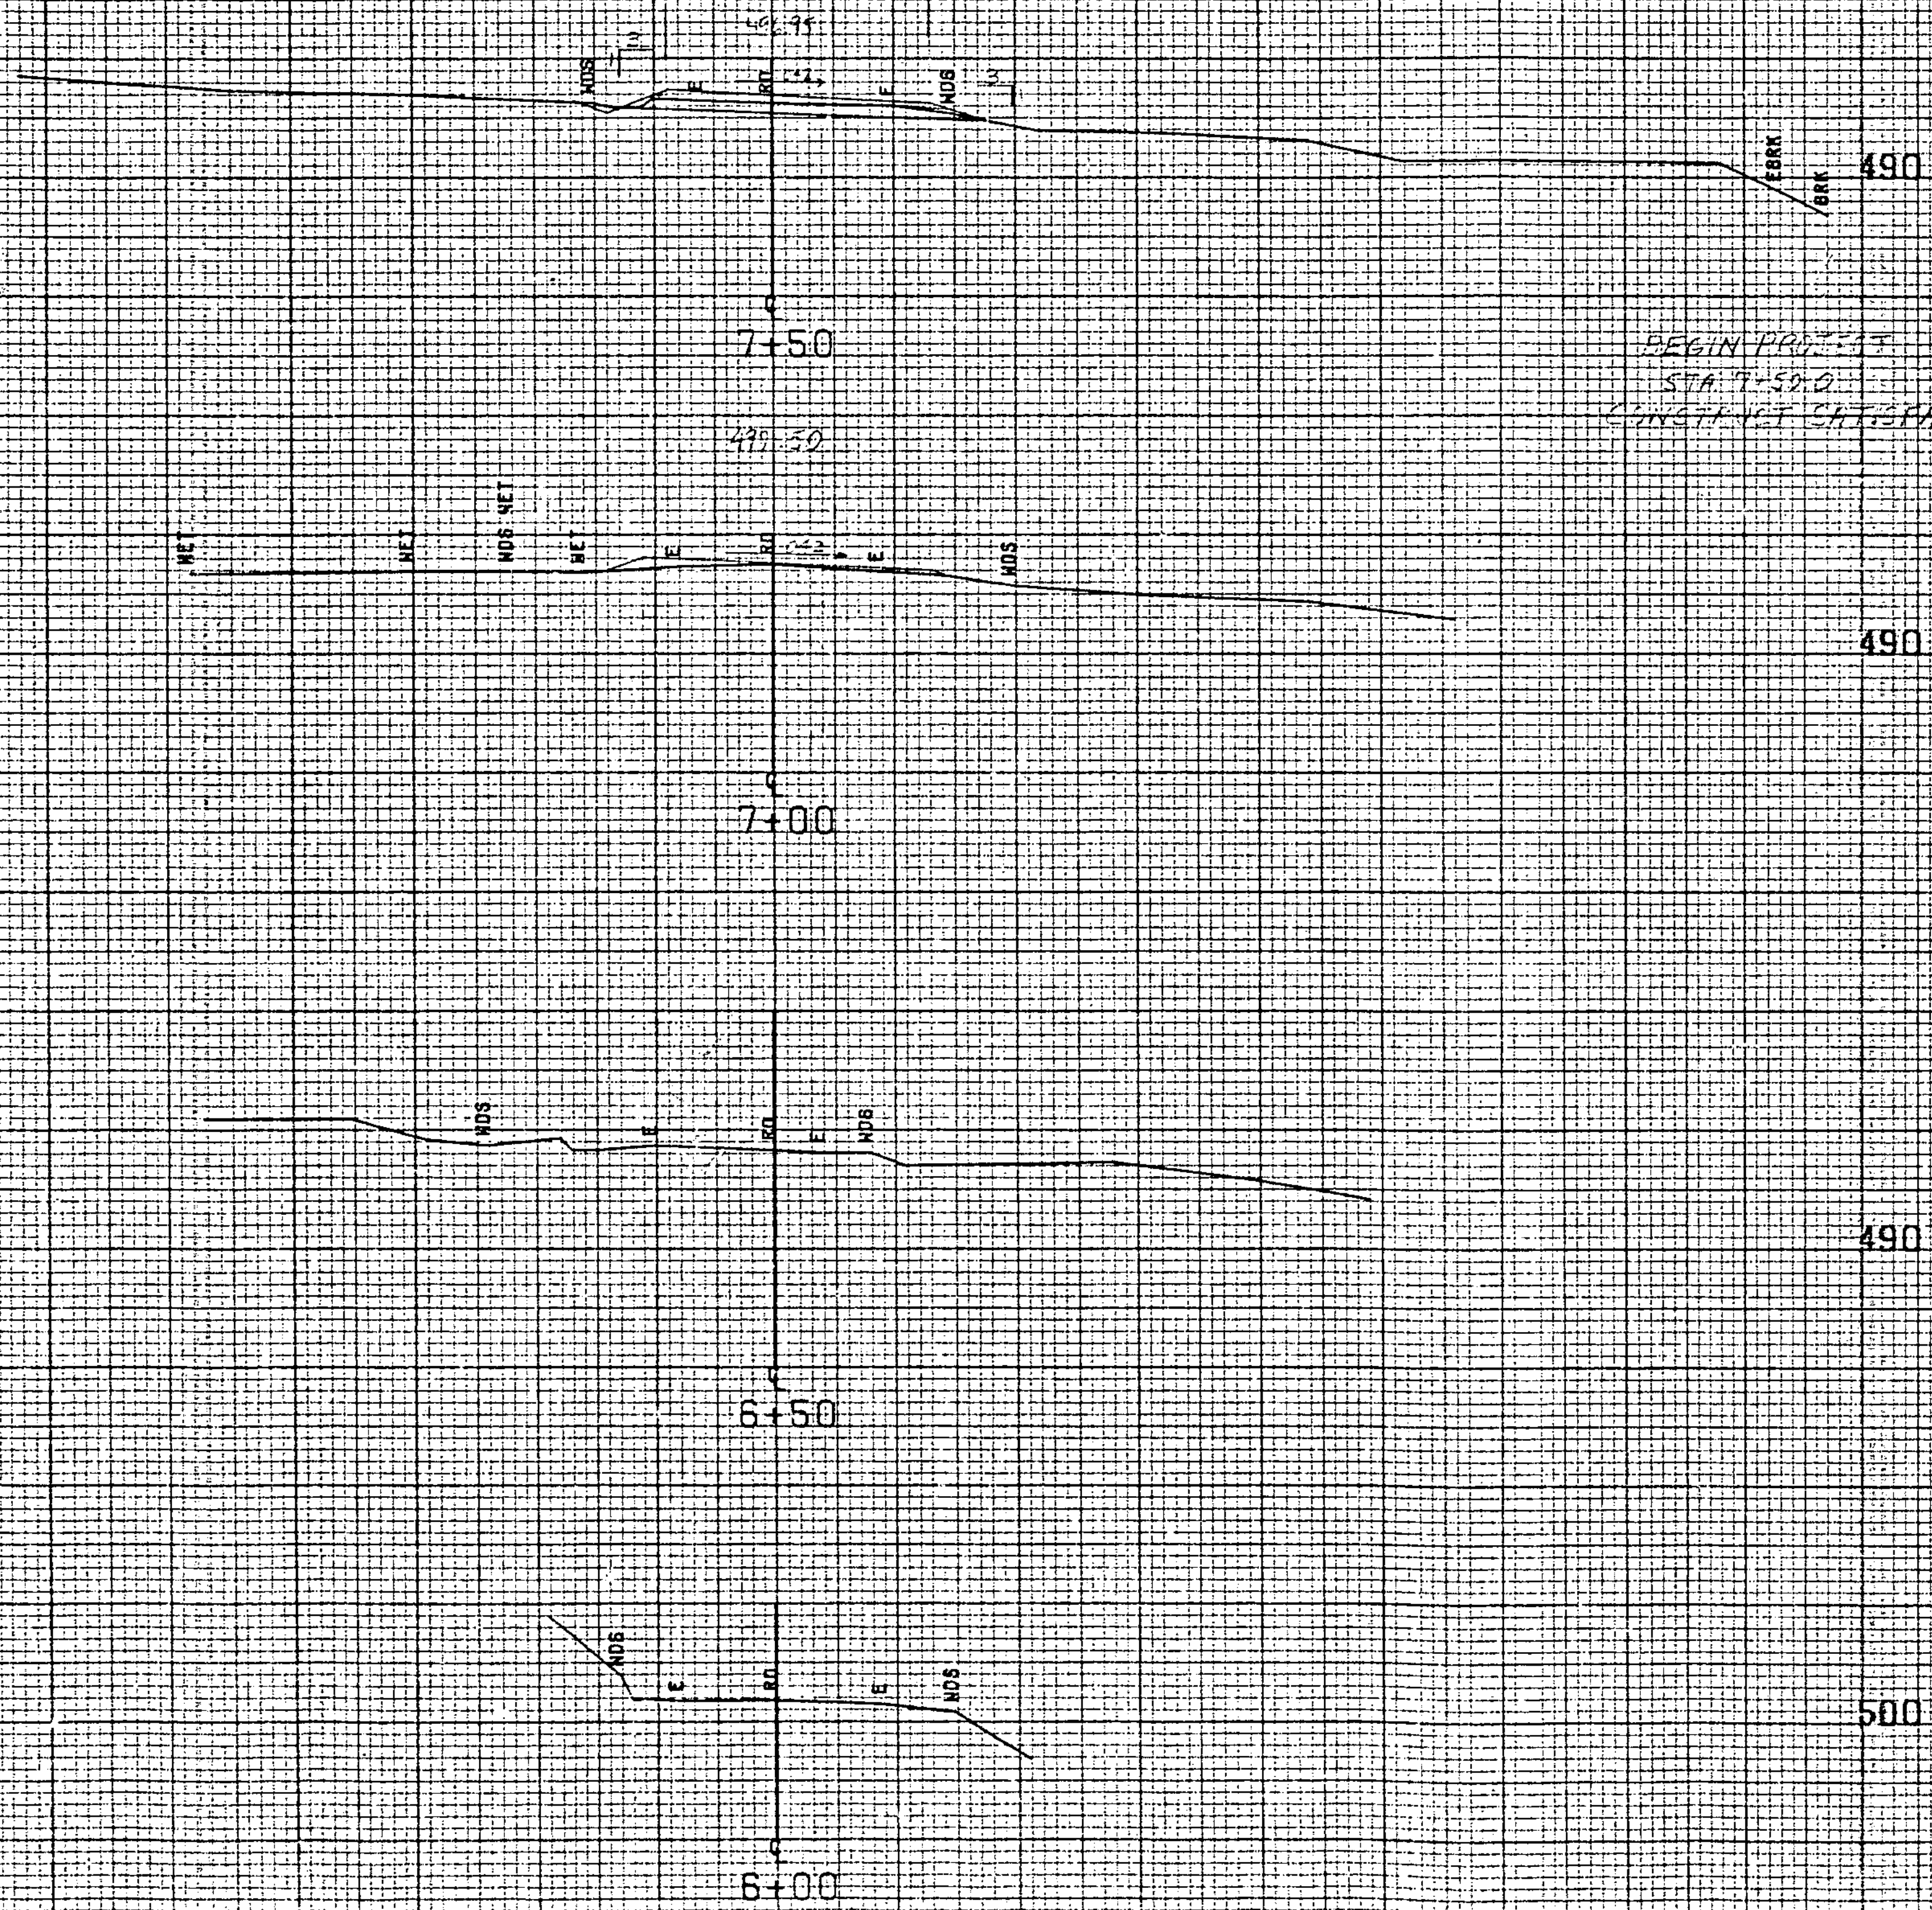

FROM STA. 6+00 TO STA. 7+50
 PROJECT NAME MORRISTOWN MAIN
 NO. FTH3631 PLOTTED: 07/20/84
 SURVEYED BY FANTONI JULY 1984