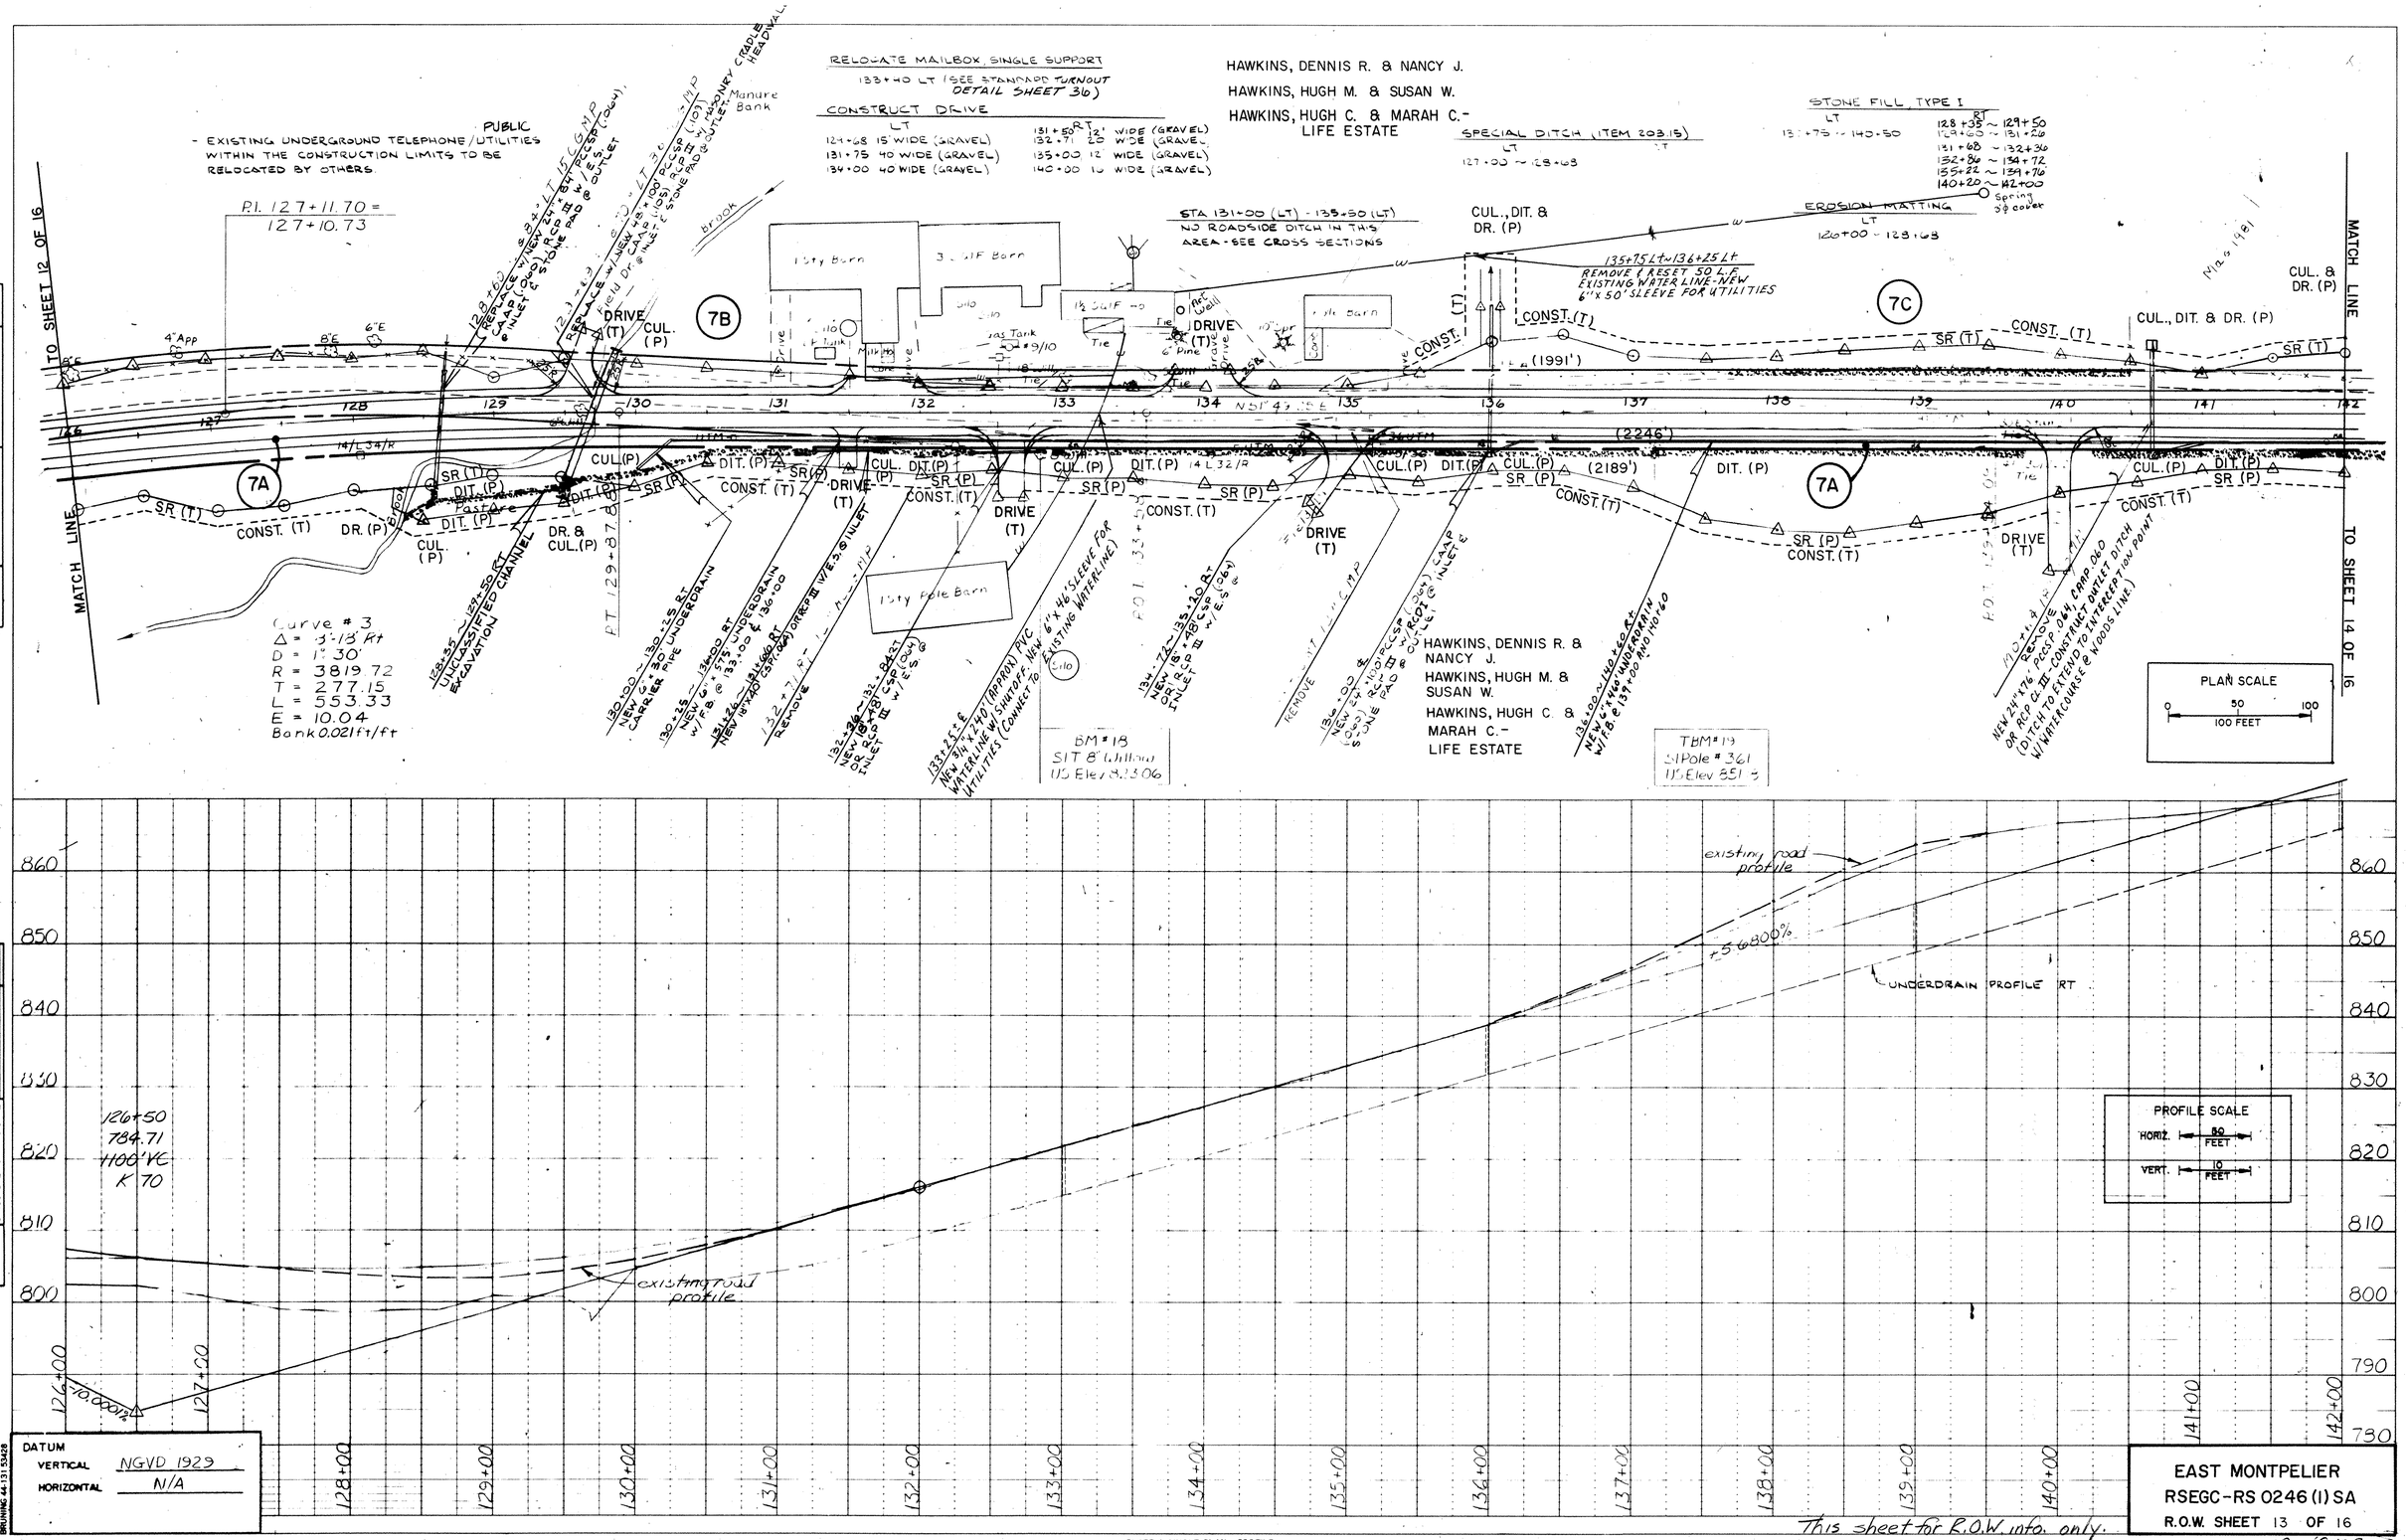

PLAN

	BY	DATE
SURVEYED		
PLOTTED	K.A.S.H./K.C.	7-26-21
ALIGNMENT CHECKED	K.A.S.T./K.C.	7-26-21
RT. OF WAY CHECKED	K.A.S.T./K.C.	

NOTE BOOK
NO.

PROFILE

	BY	DATE
SURVEYED		
PLOTTED	K.A.S.H./K.C.	7-26-21
GRADES CHECKED	K.A.S.T./K.C.	7-26-21
B. M. NOTED		
STRUCTURE NOTATIONS CHKD		

NOTE BOOK
NO.