


BY _____ DATE _____
 SURVEYED _____
 PLOTTED _____
 NOTE BOOK _____
 NO. _____

BY _____ DATE _____
 SURVEYED _____
 PLOTTED _____
 NOTE BOOK _____
 NO. _____

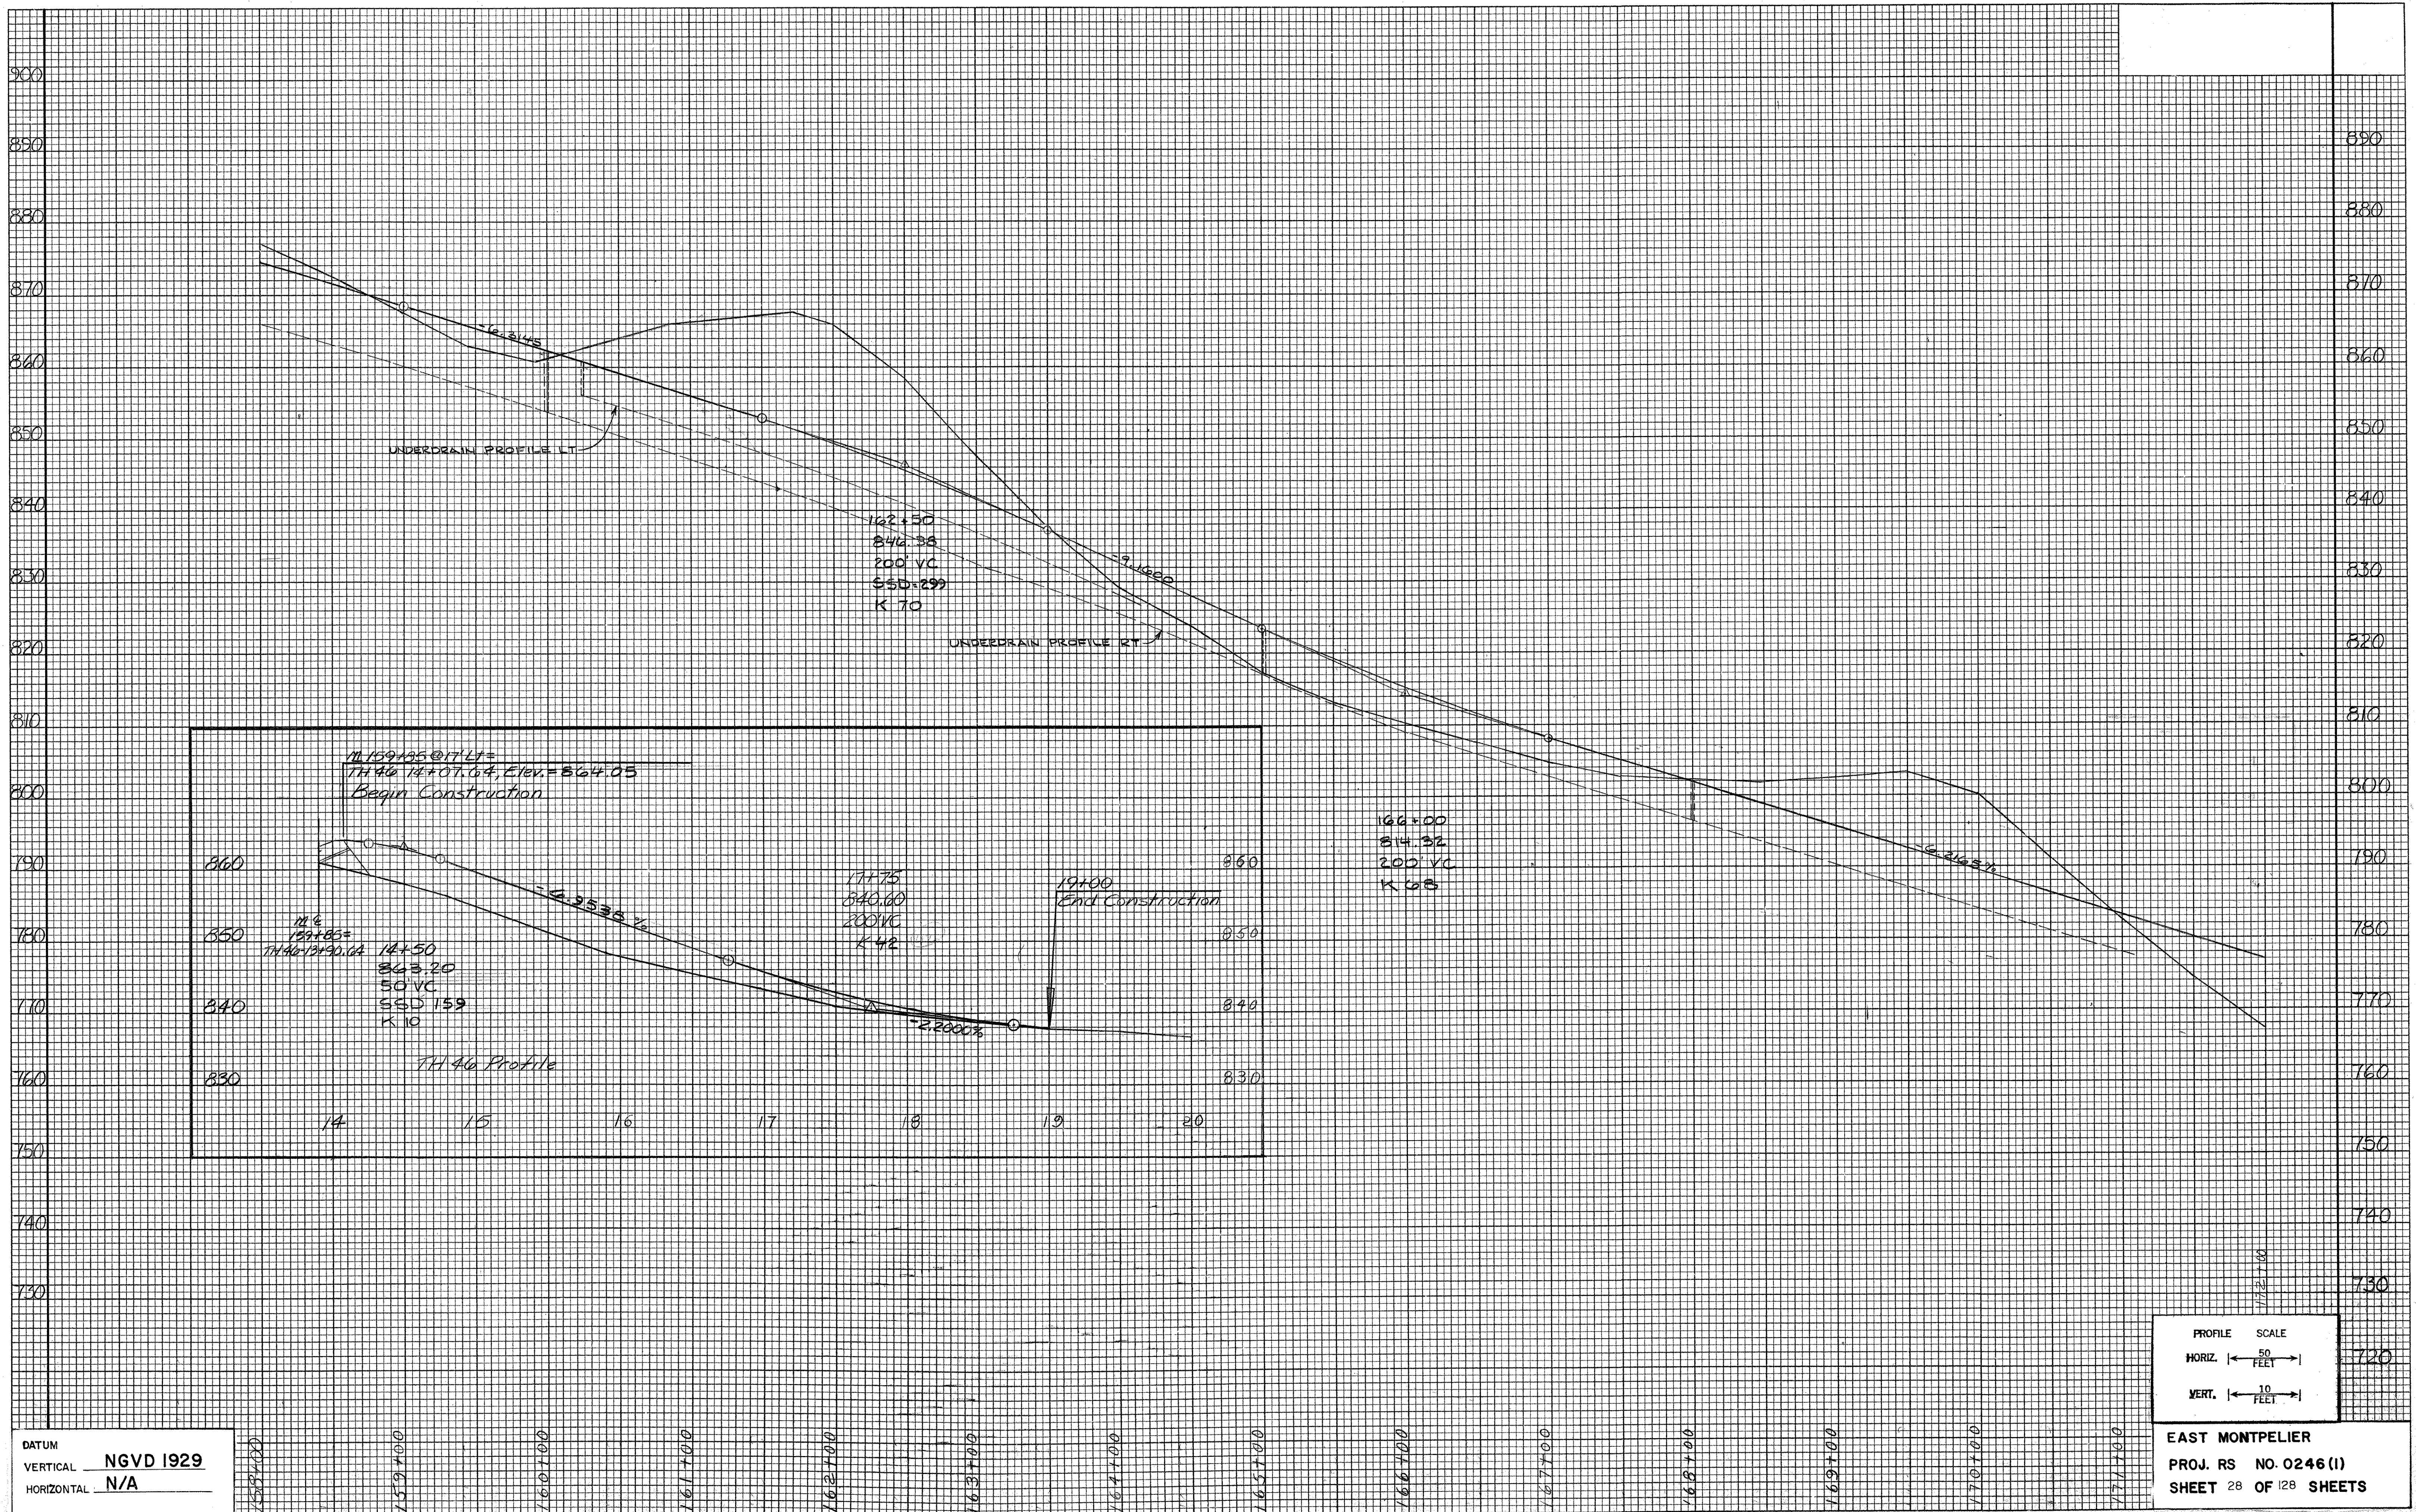

DATUM
 VERTICAL NGVD 1929
 HORIZONTAL N/A

PROFILE SCALE
 HORIZ. 50 FEET
 VERT. 10 FEET

EAST MONTPELIER
 PROJ. RS NO. 0246 (I)
 SHEET 28 OF 128 SHEETS