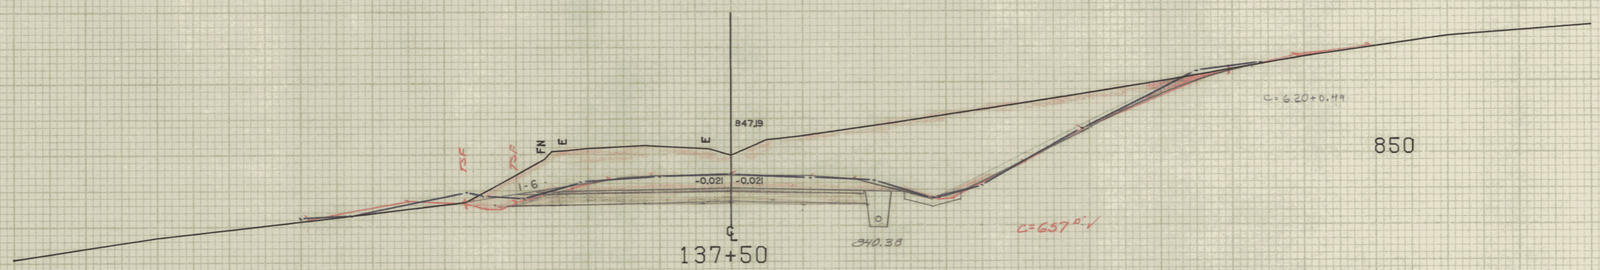

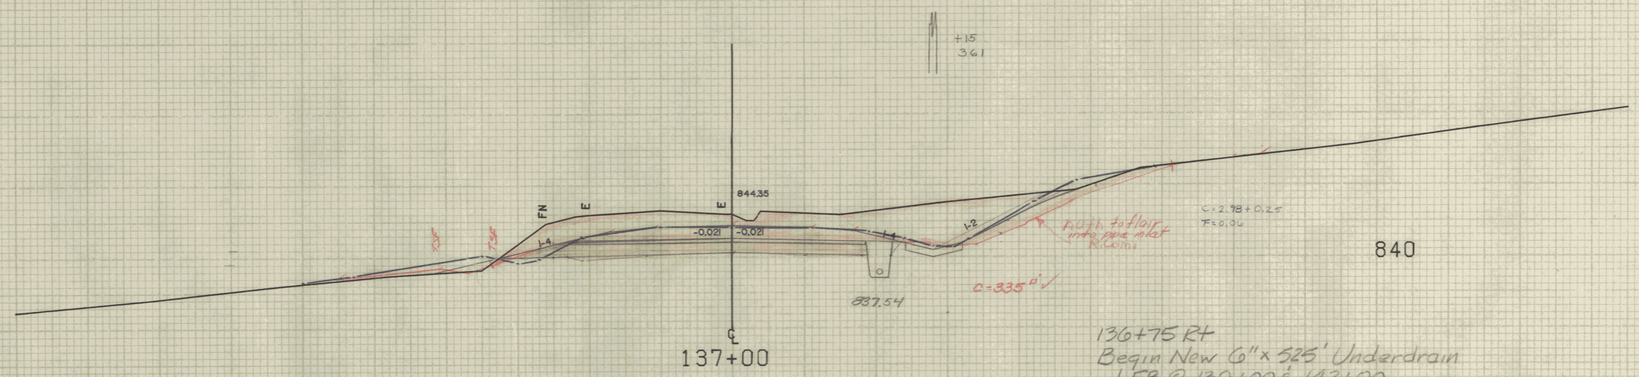

136+75 Rt
Begin New 6" x 525' Underdrain
w/ FB @ 139+00 & 142+00

Base Plan by VT Survey - Sections taken 11 May 1993 - Before Blow & Cote

Panels Plotted by R.Lom 11-5-93
Underout " " " 11-17-93
Drain " " " 12-21-93
Ord. Plan. by C.E. Kohler 1-31-94

SCALE 10 FEET

FROM STA.	137+00	TO STA.	137+50
PROJECT NAME	EAST MONTPELIER	MAIN	
NO.	RS0246(1)	PLOTTED	02/24/83
SURVEYED BY	LAVALLEE	JAN82	
SHEET 56 OF 128 SHEETS			