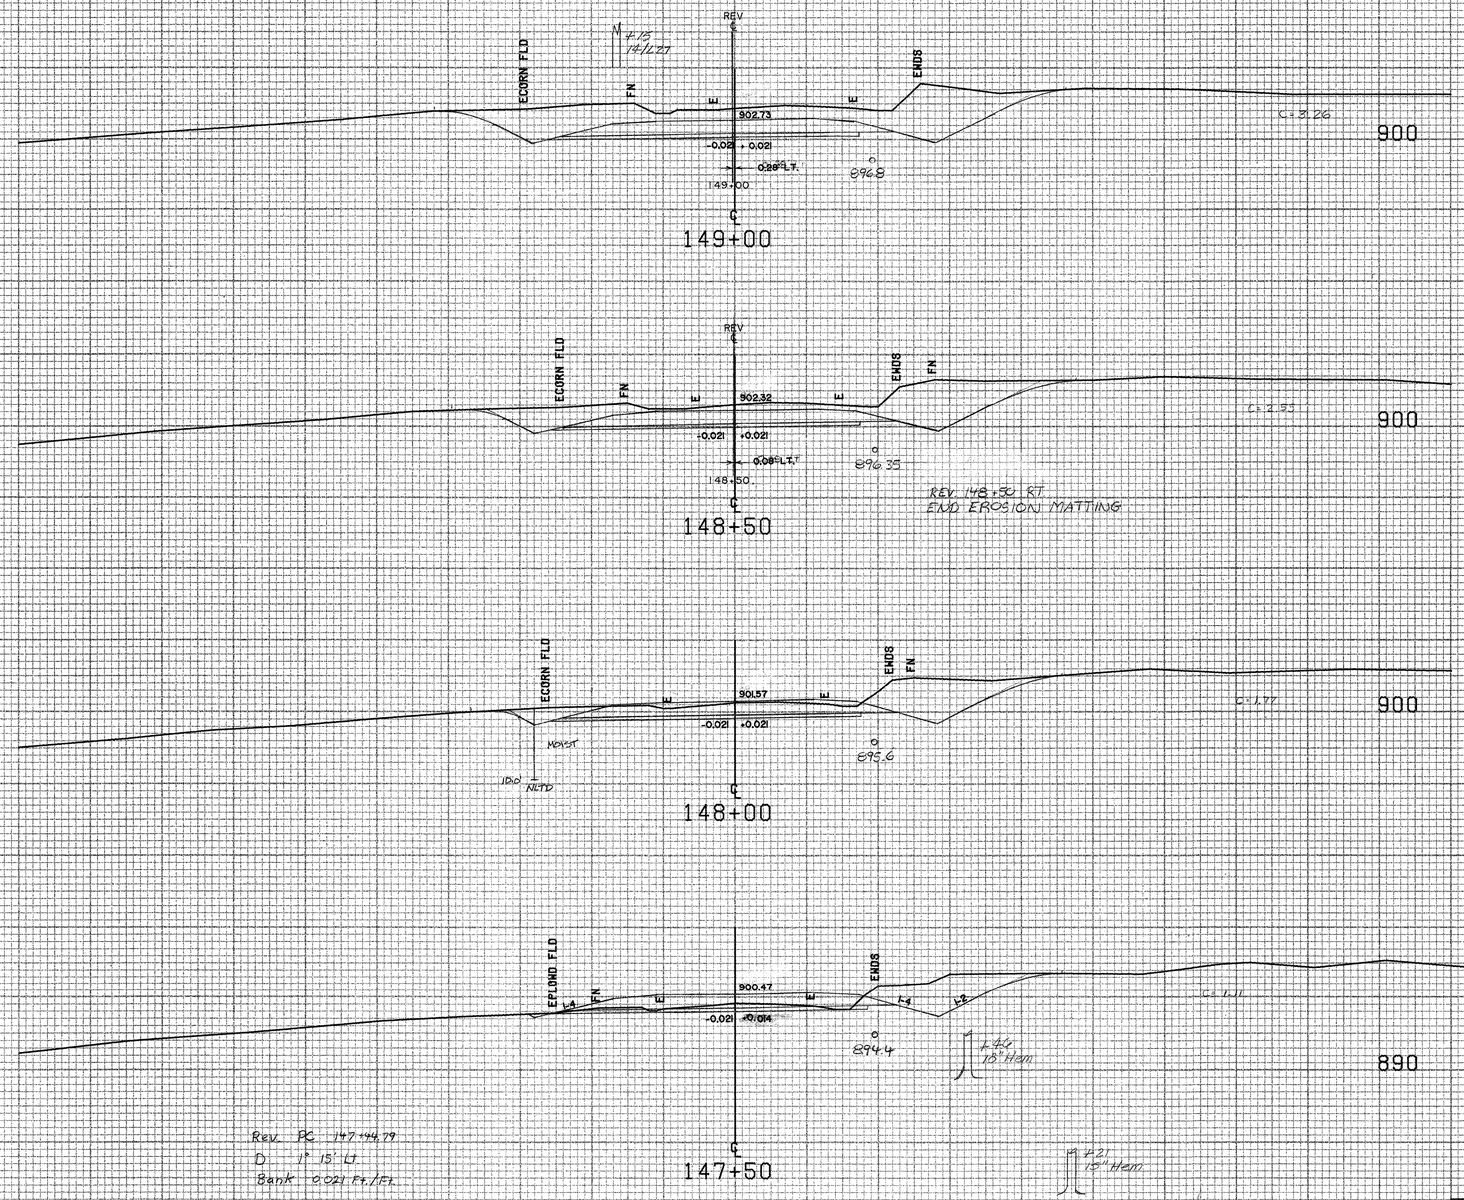

Rev. PC 147+44.79
D 1° 15' LT
Bank 0.021 Ft./Ft.

FROM STA. 147+50		TO STA. 149+00	
PROJECT NAME	EAST MONTPELIER		MAIN2
NO.	RS0246(1)		PLOTTED 04/18/85
SURVEYED BY	FALL		APRIL 1985
SHEET 54 OF 129 SHEETS			

SCALE 10 FEET