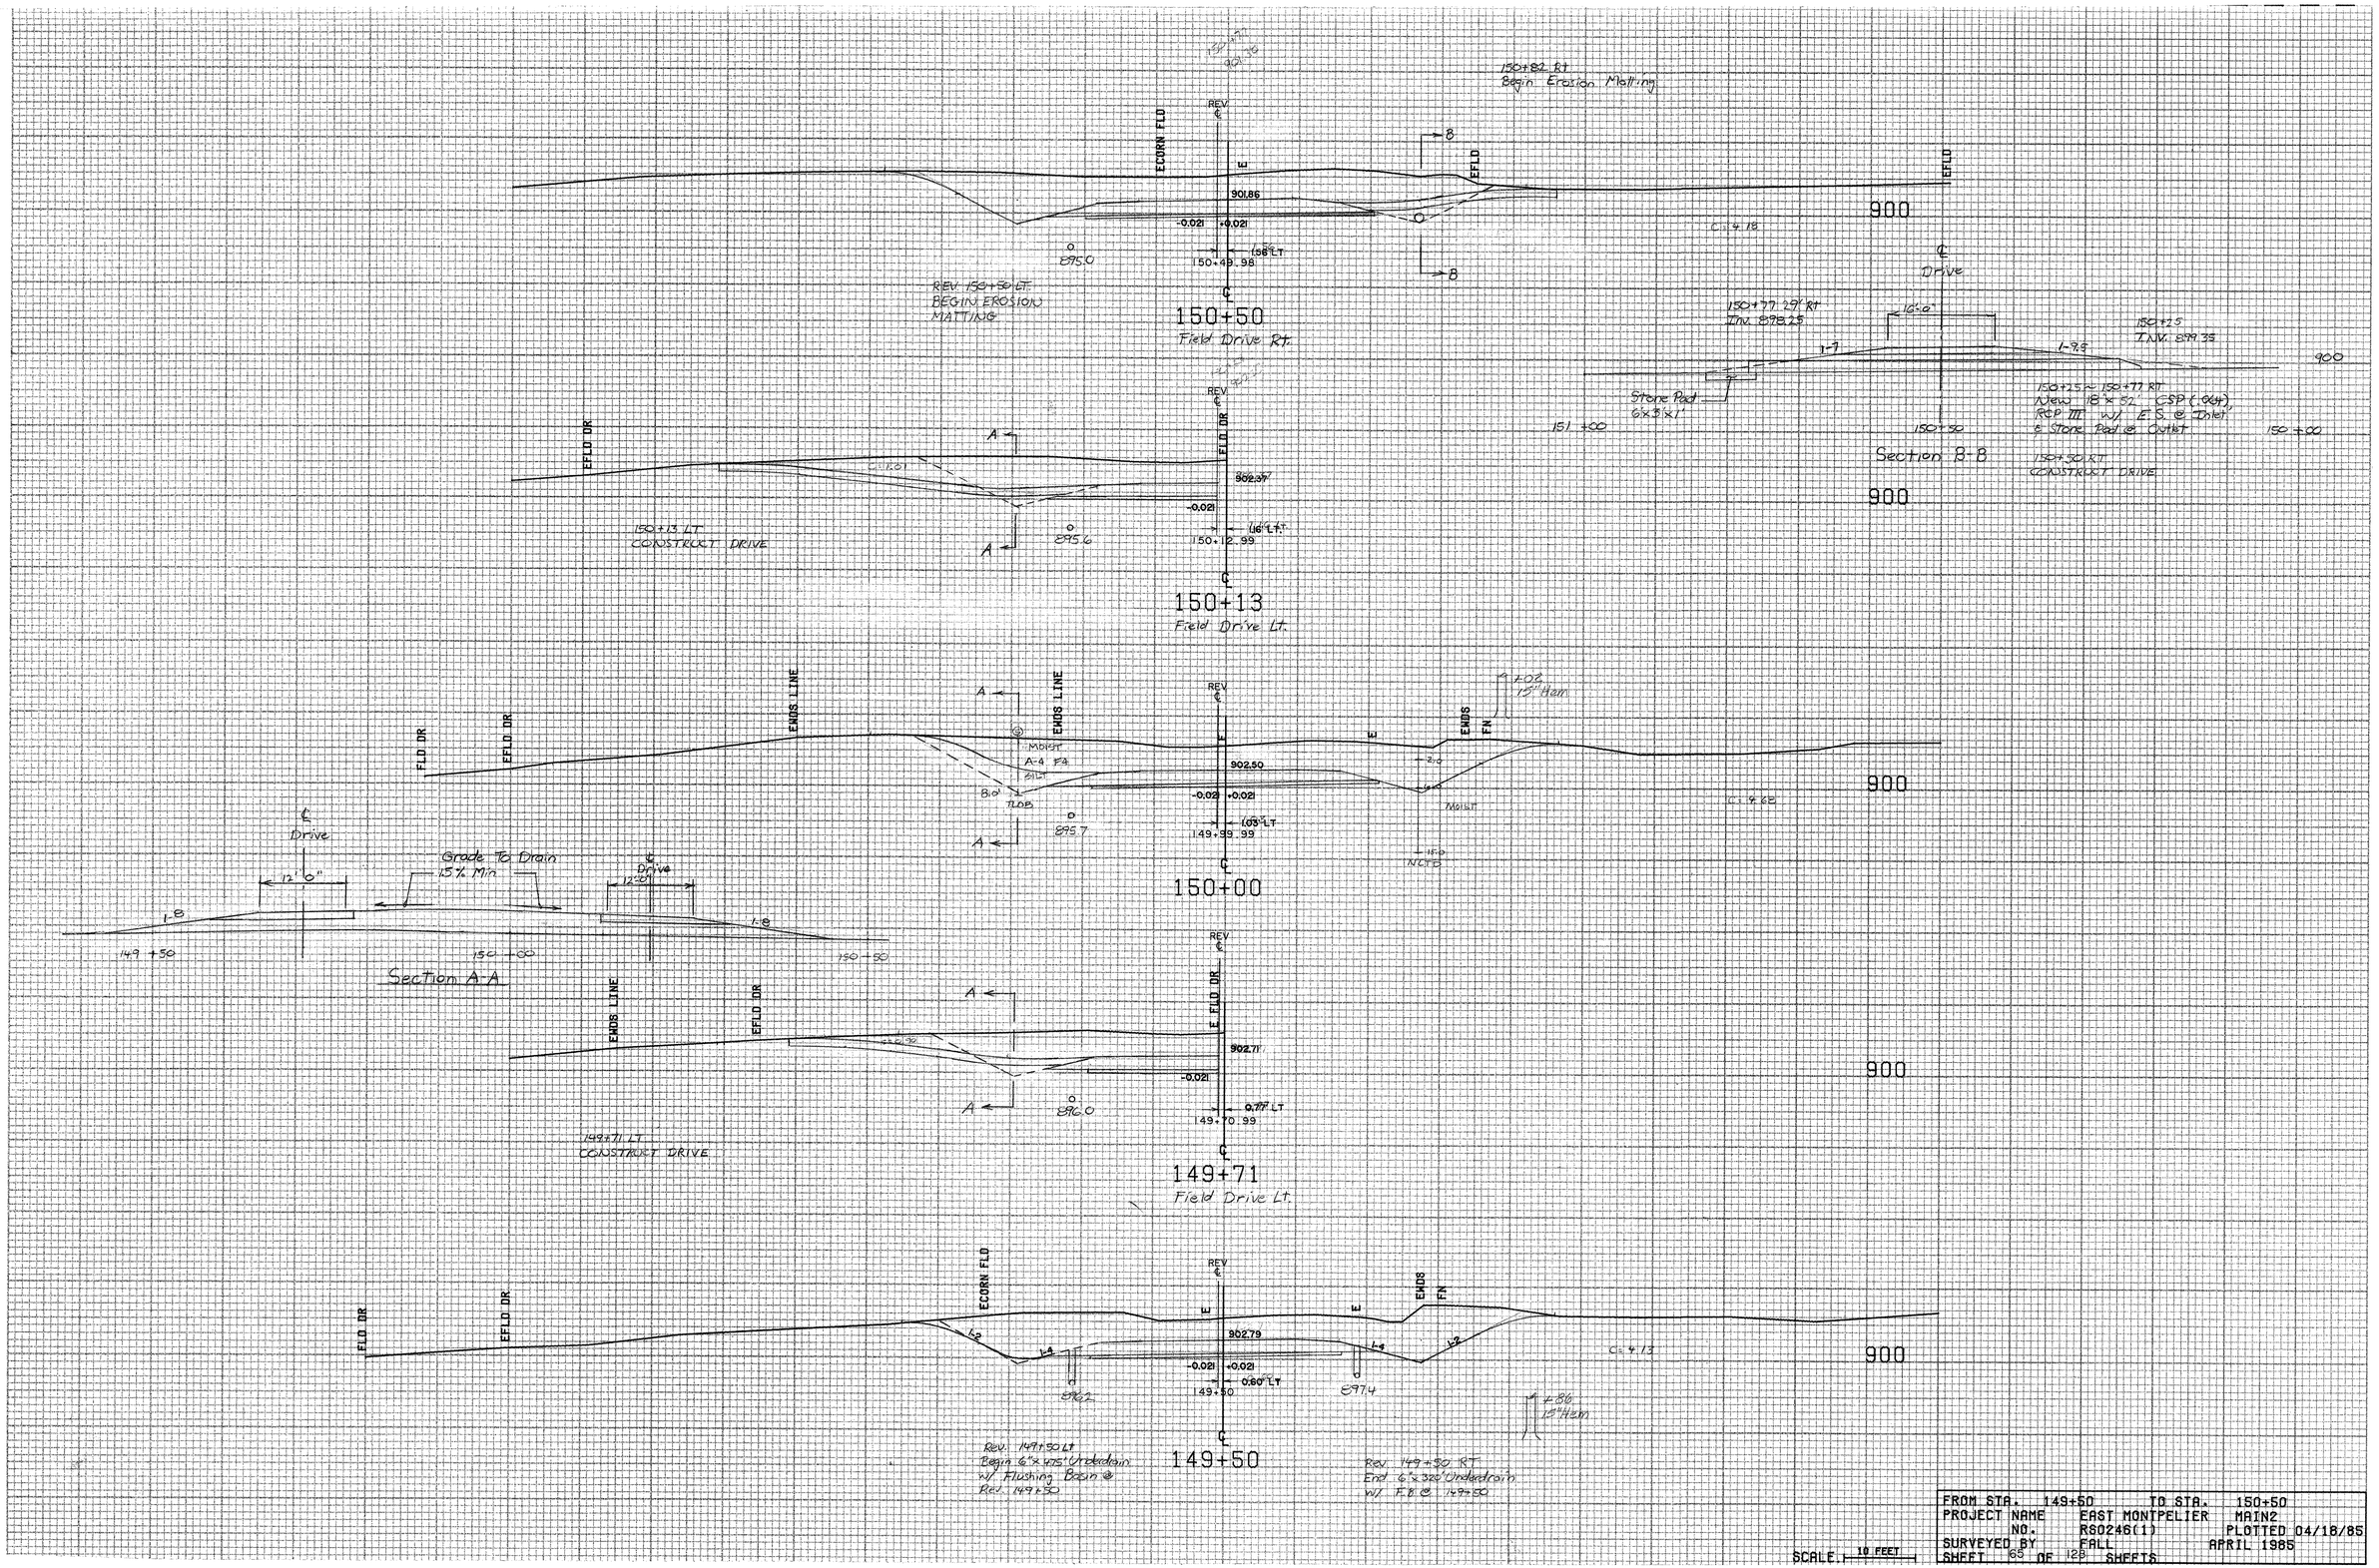

FROM STA. 149+50		TO STA. 150+50	
PROJECT NAME	EAST MONTPELIER	MAIN2	
NO.	RS0246(1)		PLOTTED 04/18/85
SURVEYED BY	FALL		APRIL 1985
SHEET 65 OF 128 SHEETS			