


TH 46 DETAIL  
SCALE: 1"=20'

Rev TH 46 13+90.64  
@ 90° turn to curve

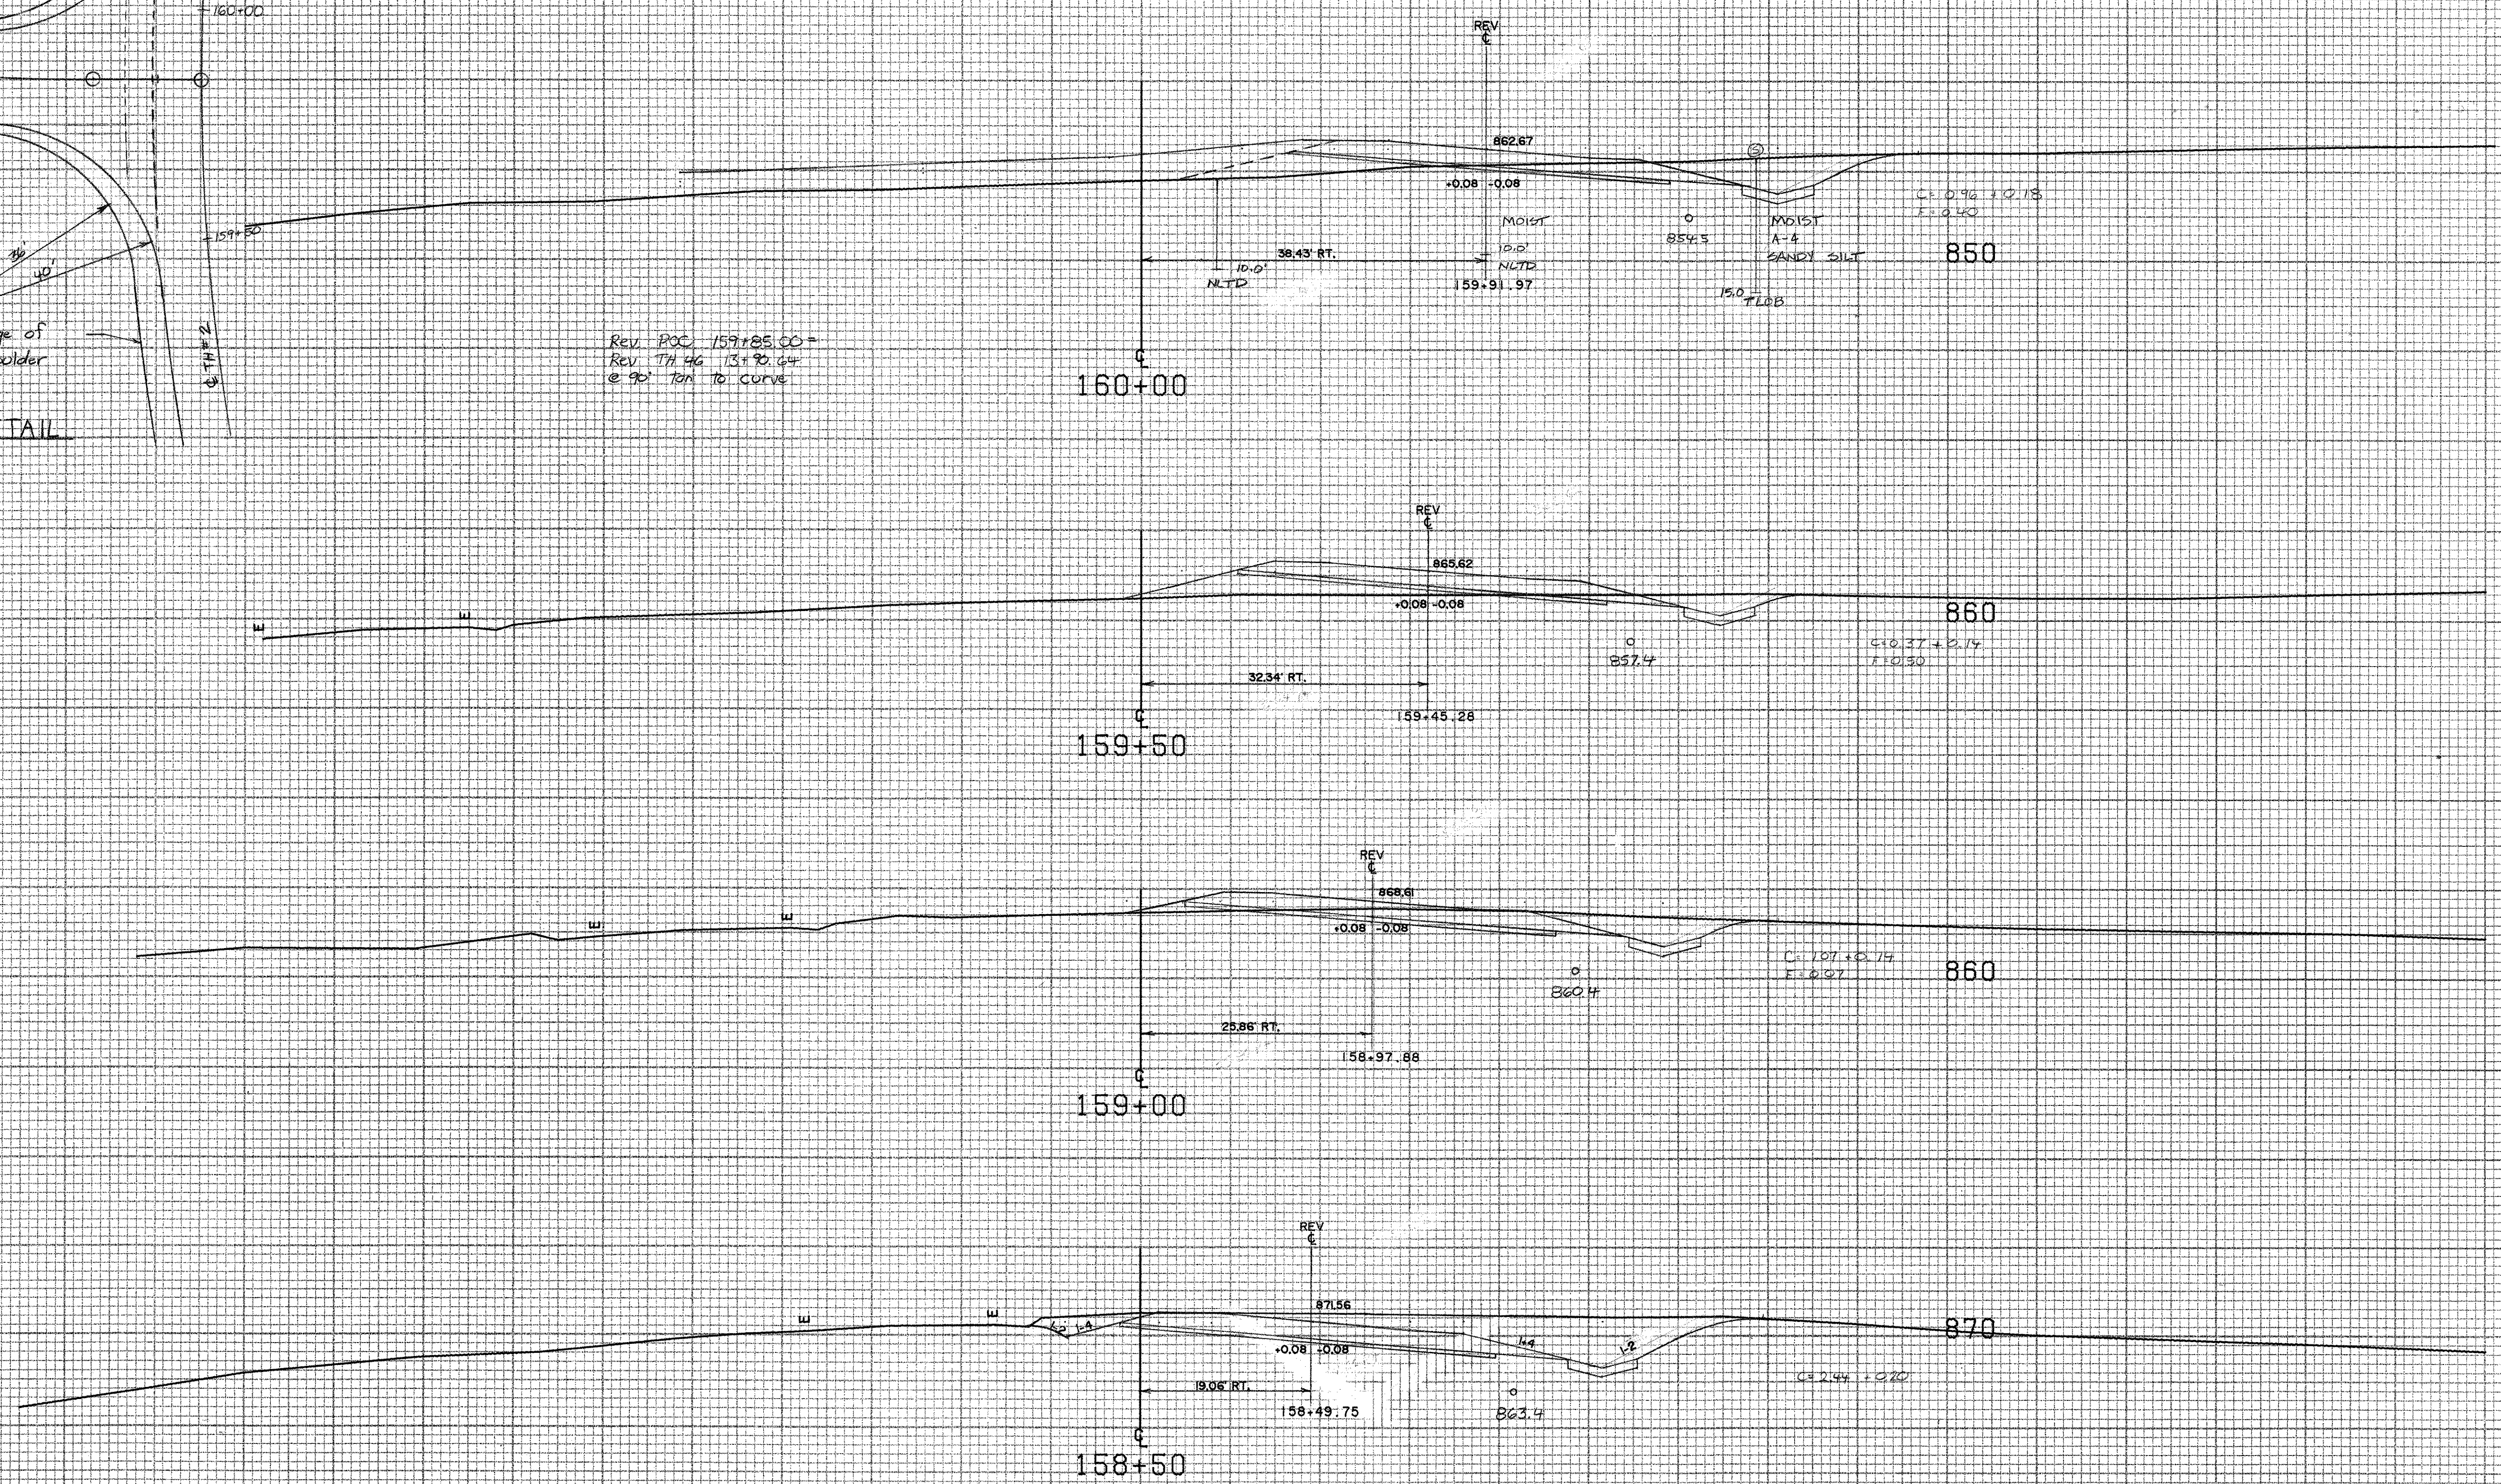

FROM STA.	158+50	TO STA.	160+00
PROJECT NAME	EAST MONTPELIER MAIN2		
NO.	R30246(1)	PLOTTED	04/18/85
SURVEYED BY	FALL	APRIL	1985
SHEET	70	OF	128 SHEETS

SCALE 1"=10 FEET