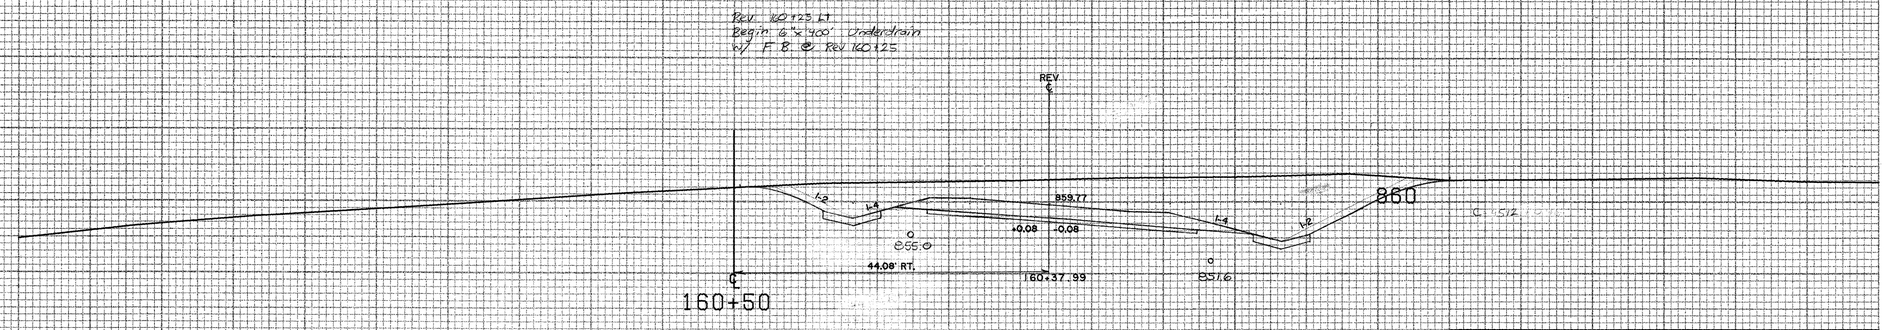

SCALE 10 FEET

FROM STA.	160+50	TO STA.	160+50
PROJECT NAME	EAST MONTPELIER		MAIN2
NO.	RS0246(1)		PLOTTED 04/18/85
SURVEYED BY	FALL		APRIL 1985
SHEET 74 OF 128	SHEETS		