GRANULAR BORROW
JORDAN PIT

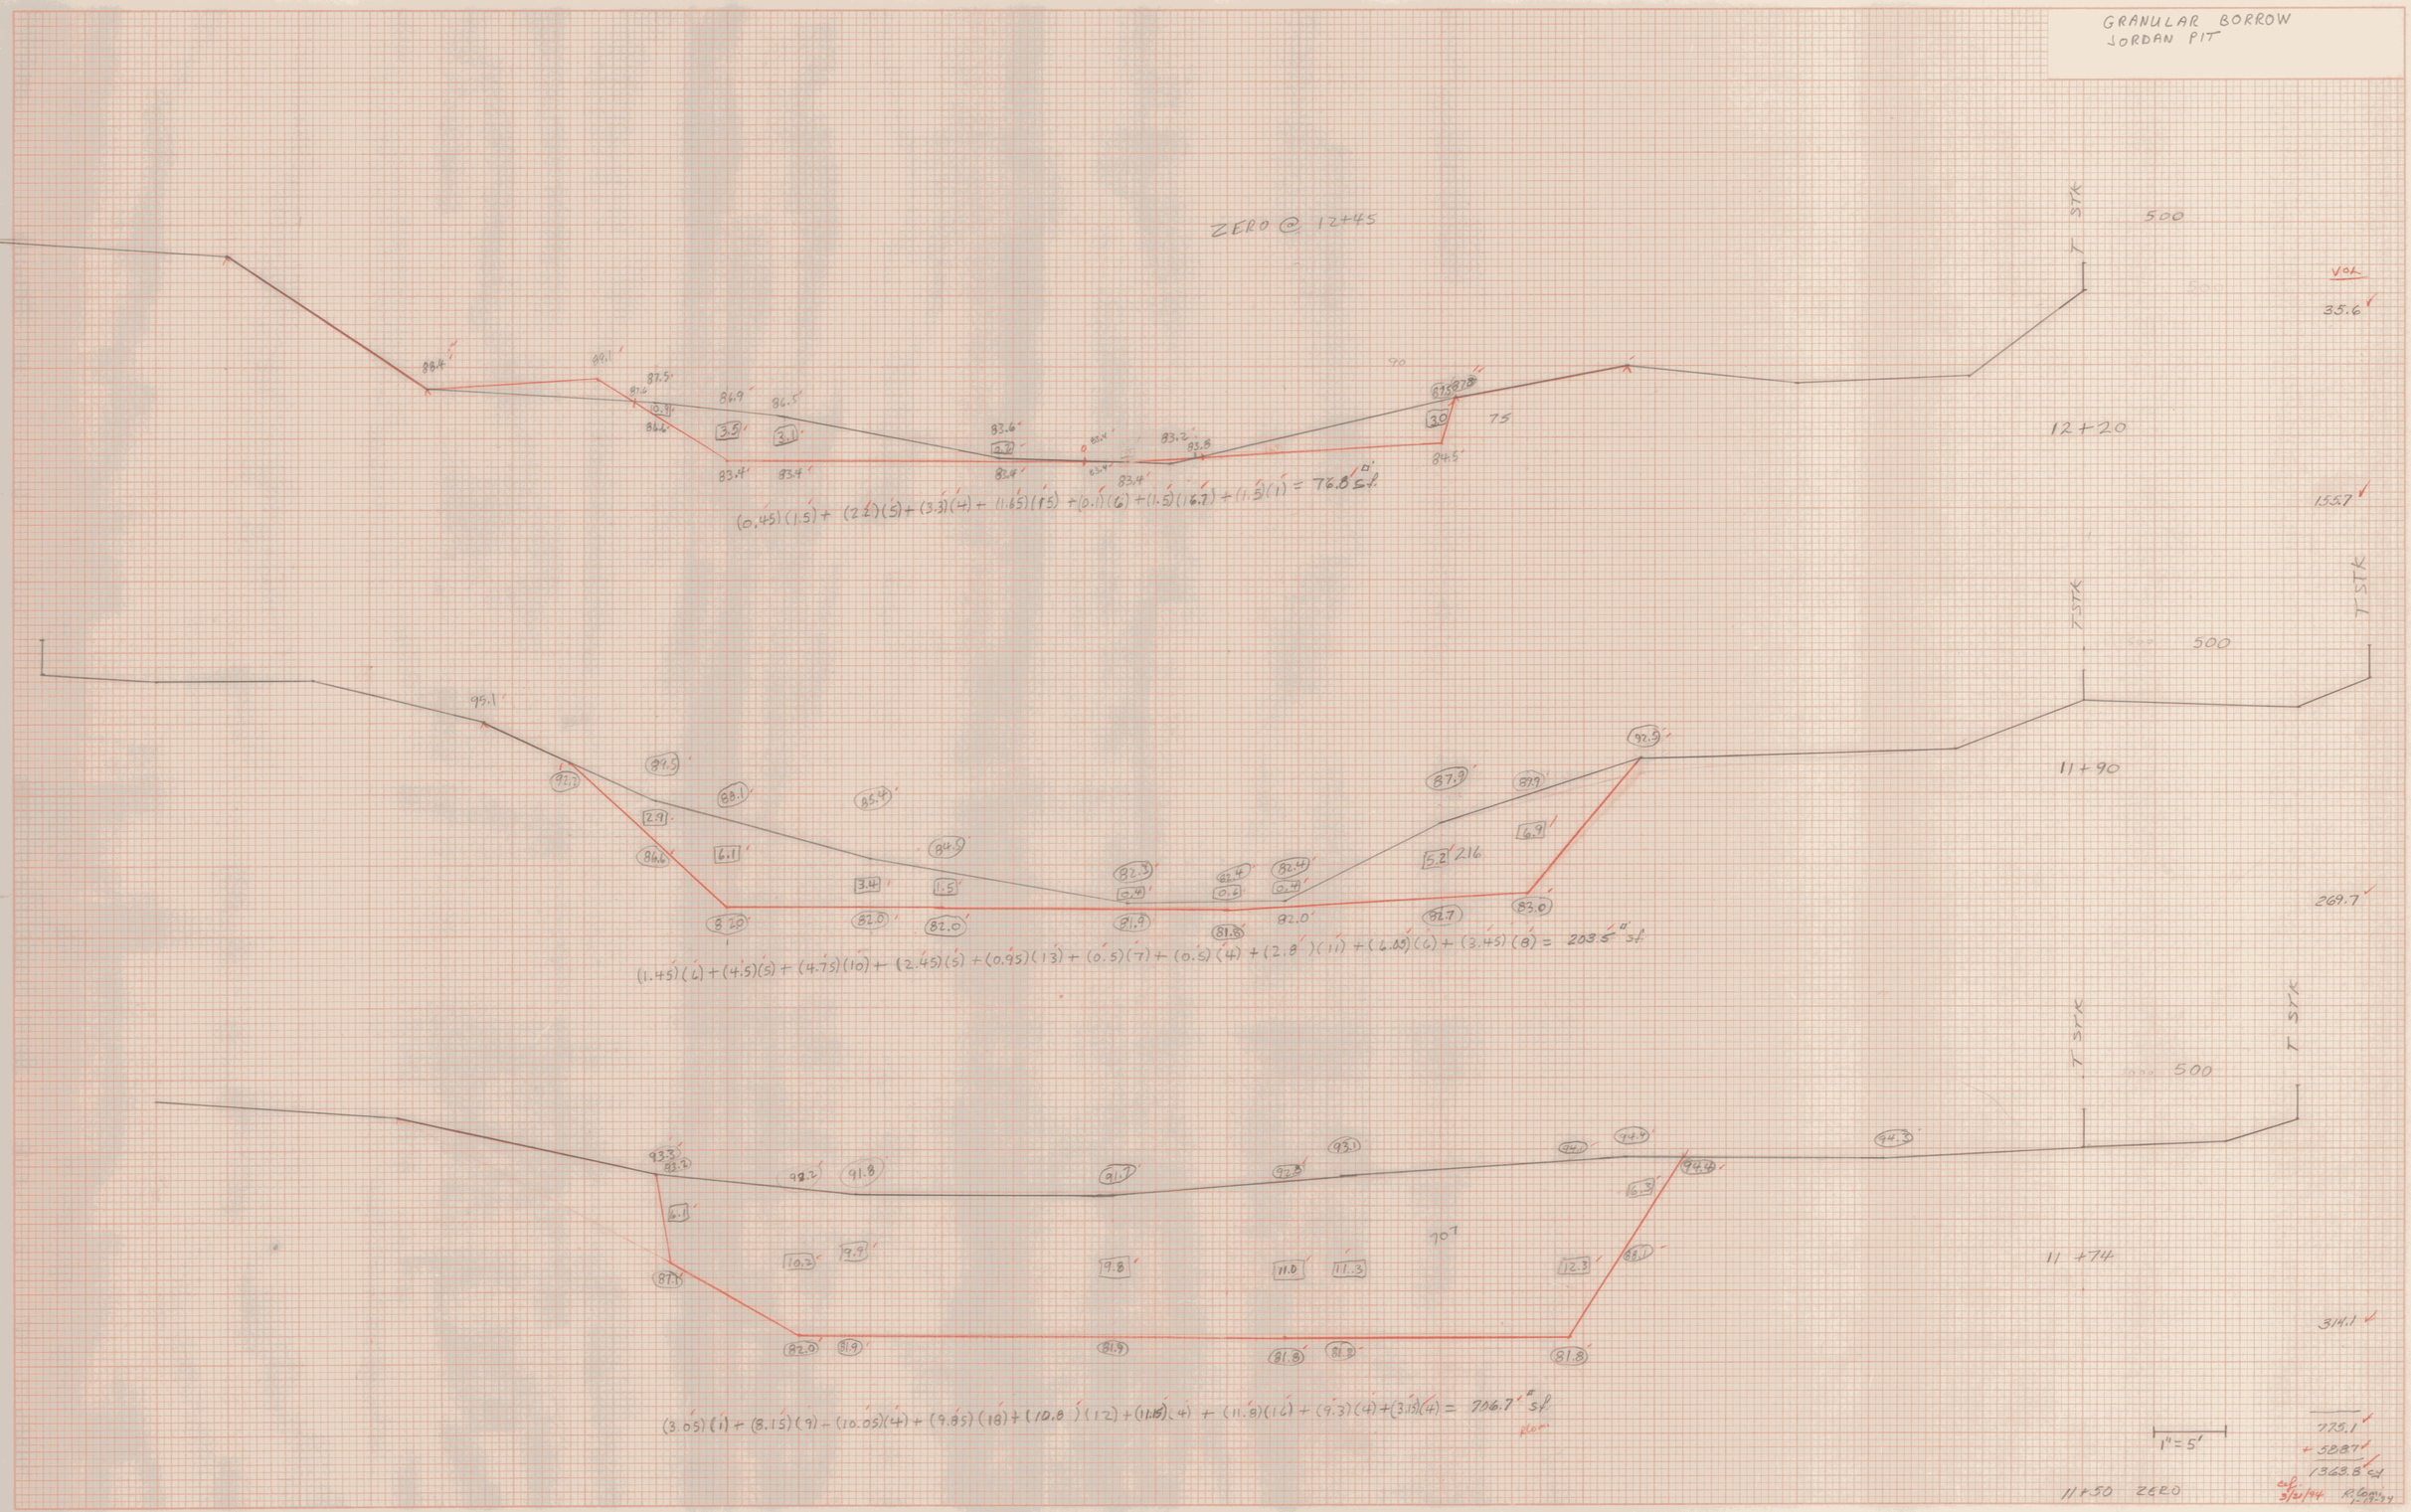

(0.45)(1.5) + (2.2)(5) + (3.3)(4) + (11.65)(15) + (0.1)(6) + (1.5)(16.7) + (1.5)(1) = 76.85 sf

(1.45)(6) + (4.5)(5) + (4.75)(10) + (2.45)(5) + (0.95)(13) + (0.5)(7) + (0.5)(4) + (2.8)(11) + (6.05)(6) + (3.45)(8) = 203.5 sf

(3.05)(1) + (8.15)(9) + (10.05)(4) + (9.85)(18) + (10.8)(12) + (11.8)(4) + (11.8)(16) + (9.3)(4) + (3.15)(4) = 706.7 sf

Keuffel & Esser Company PLATE 3, CROSS SECTION 487056 Made in U.S.A.

131 GBP