Kenneth B. Esser Company

PLATE 3 CROSS SECTION 48 TO 56 MADE IN U.S.A.

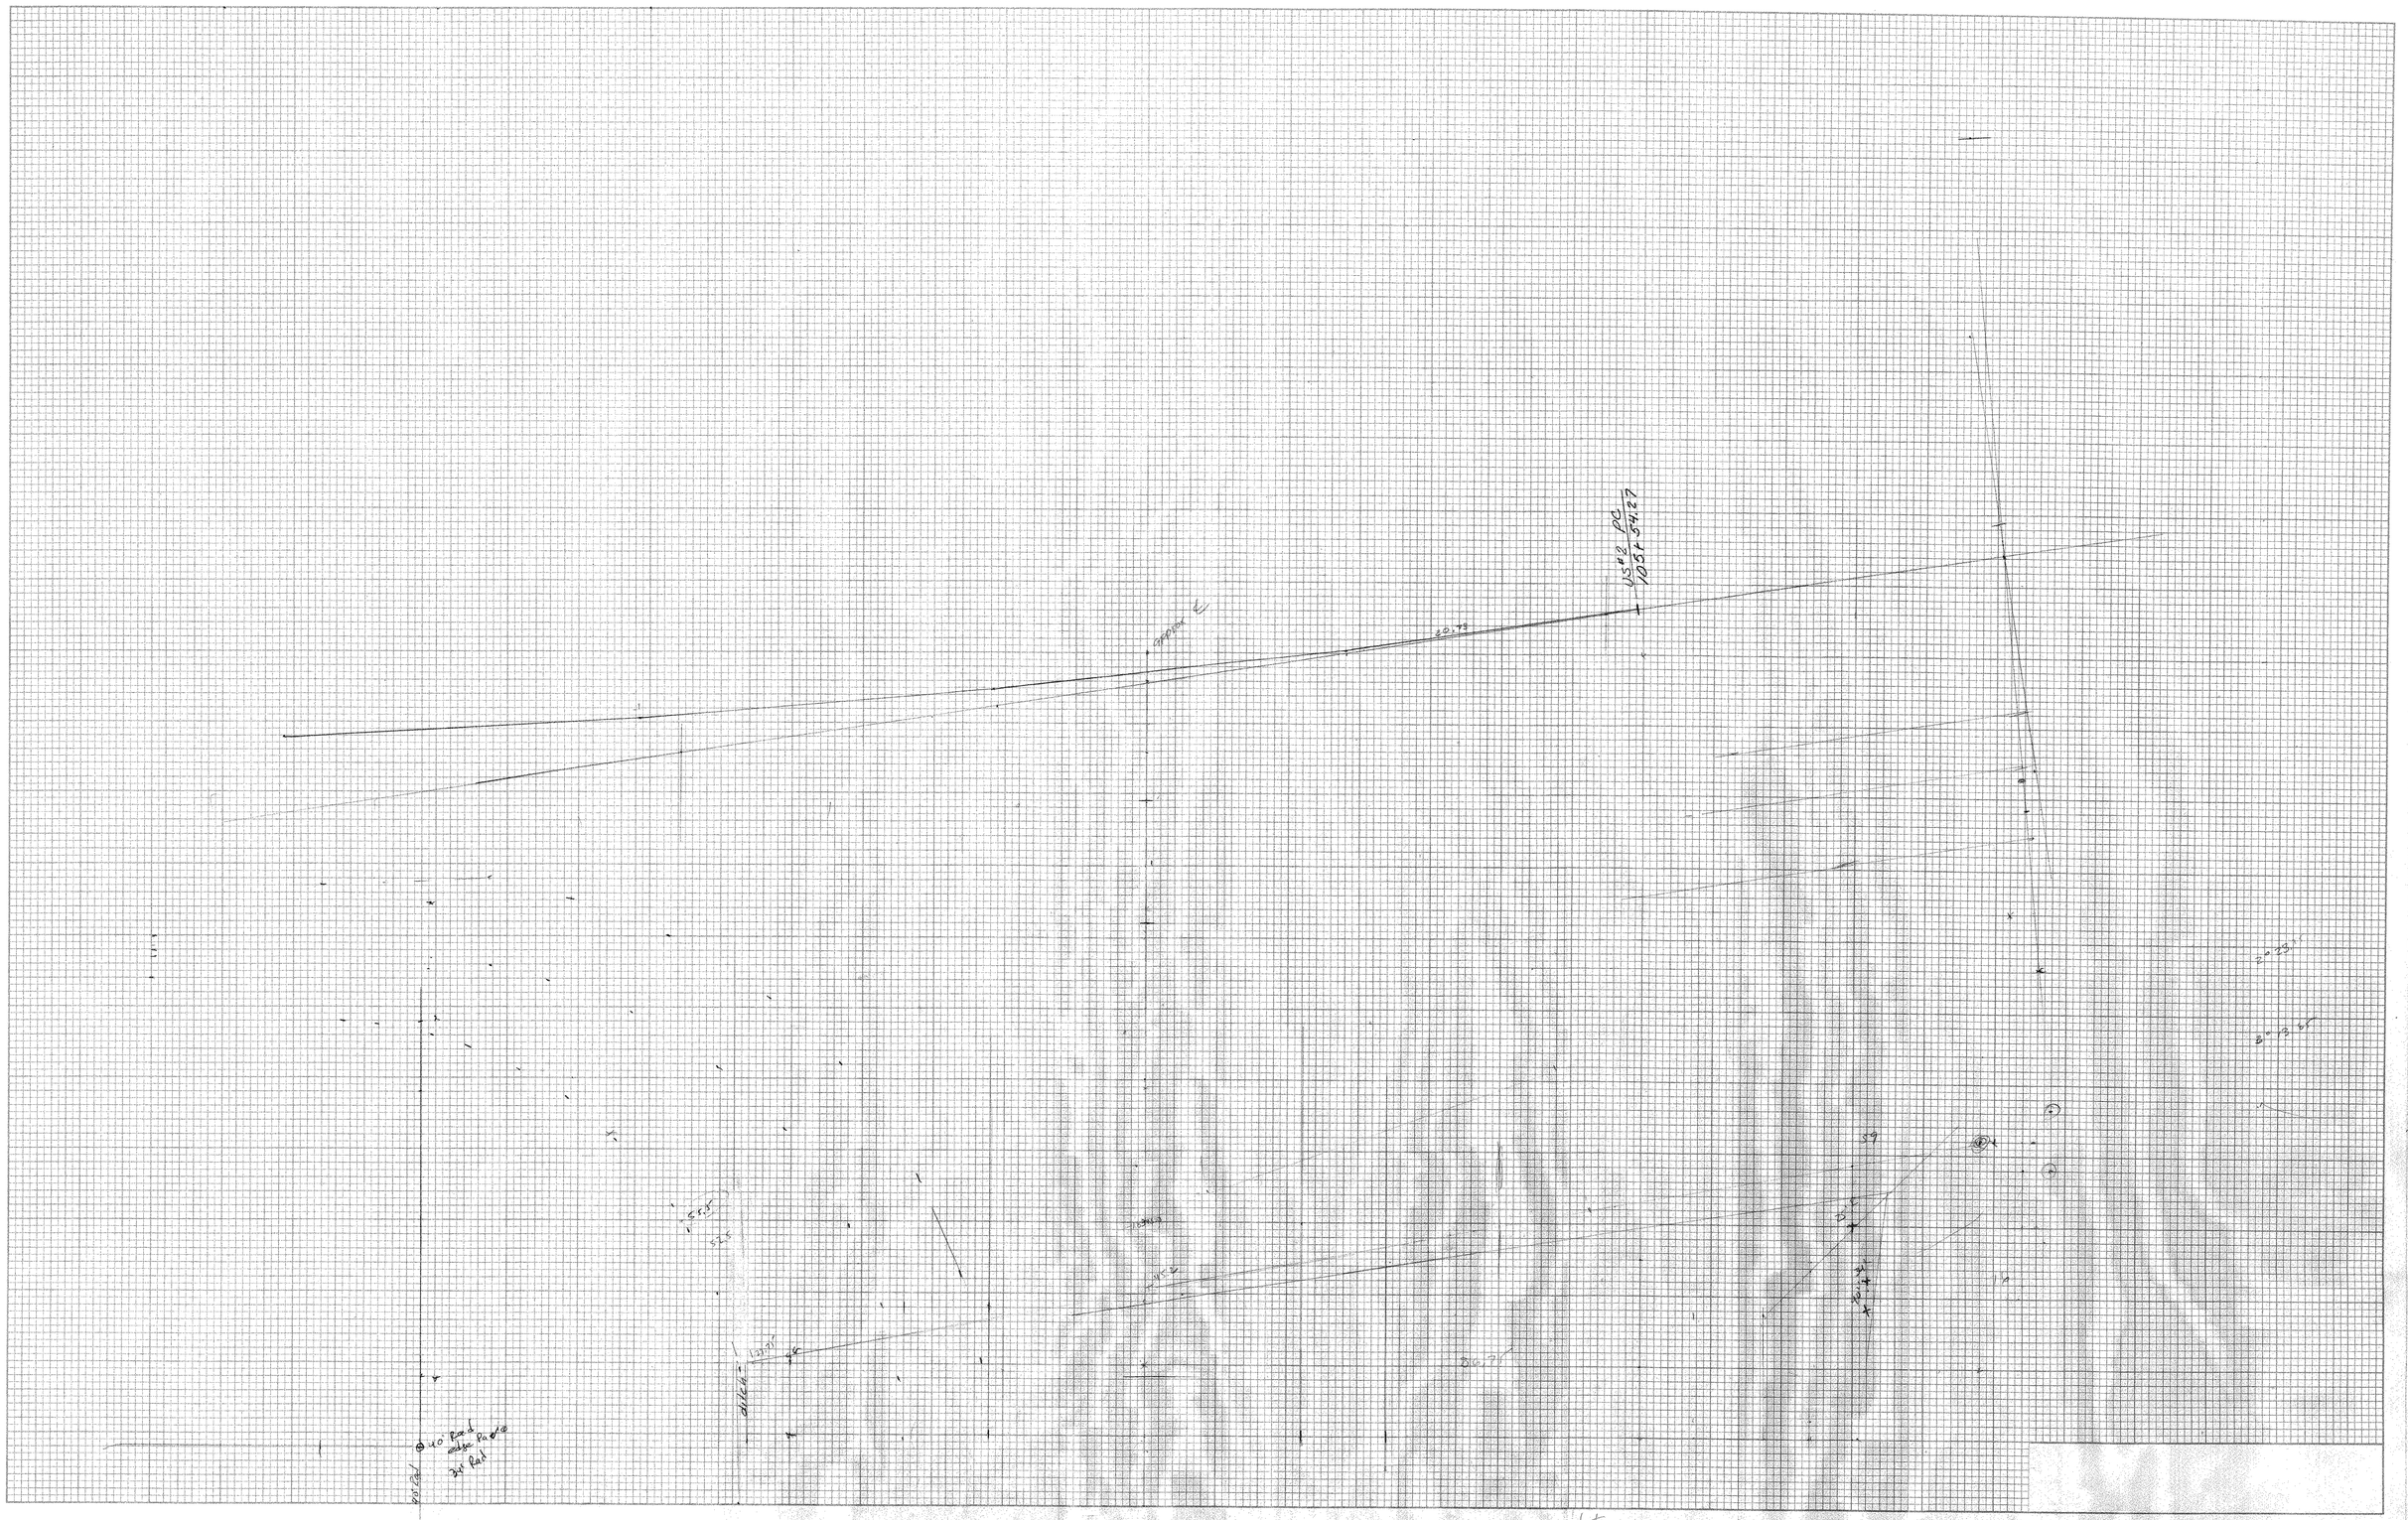
PC
105+34.27
20.75
10.00
2.75
5.25
5.5
2.75
2.75
2.75