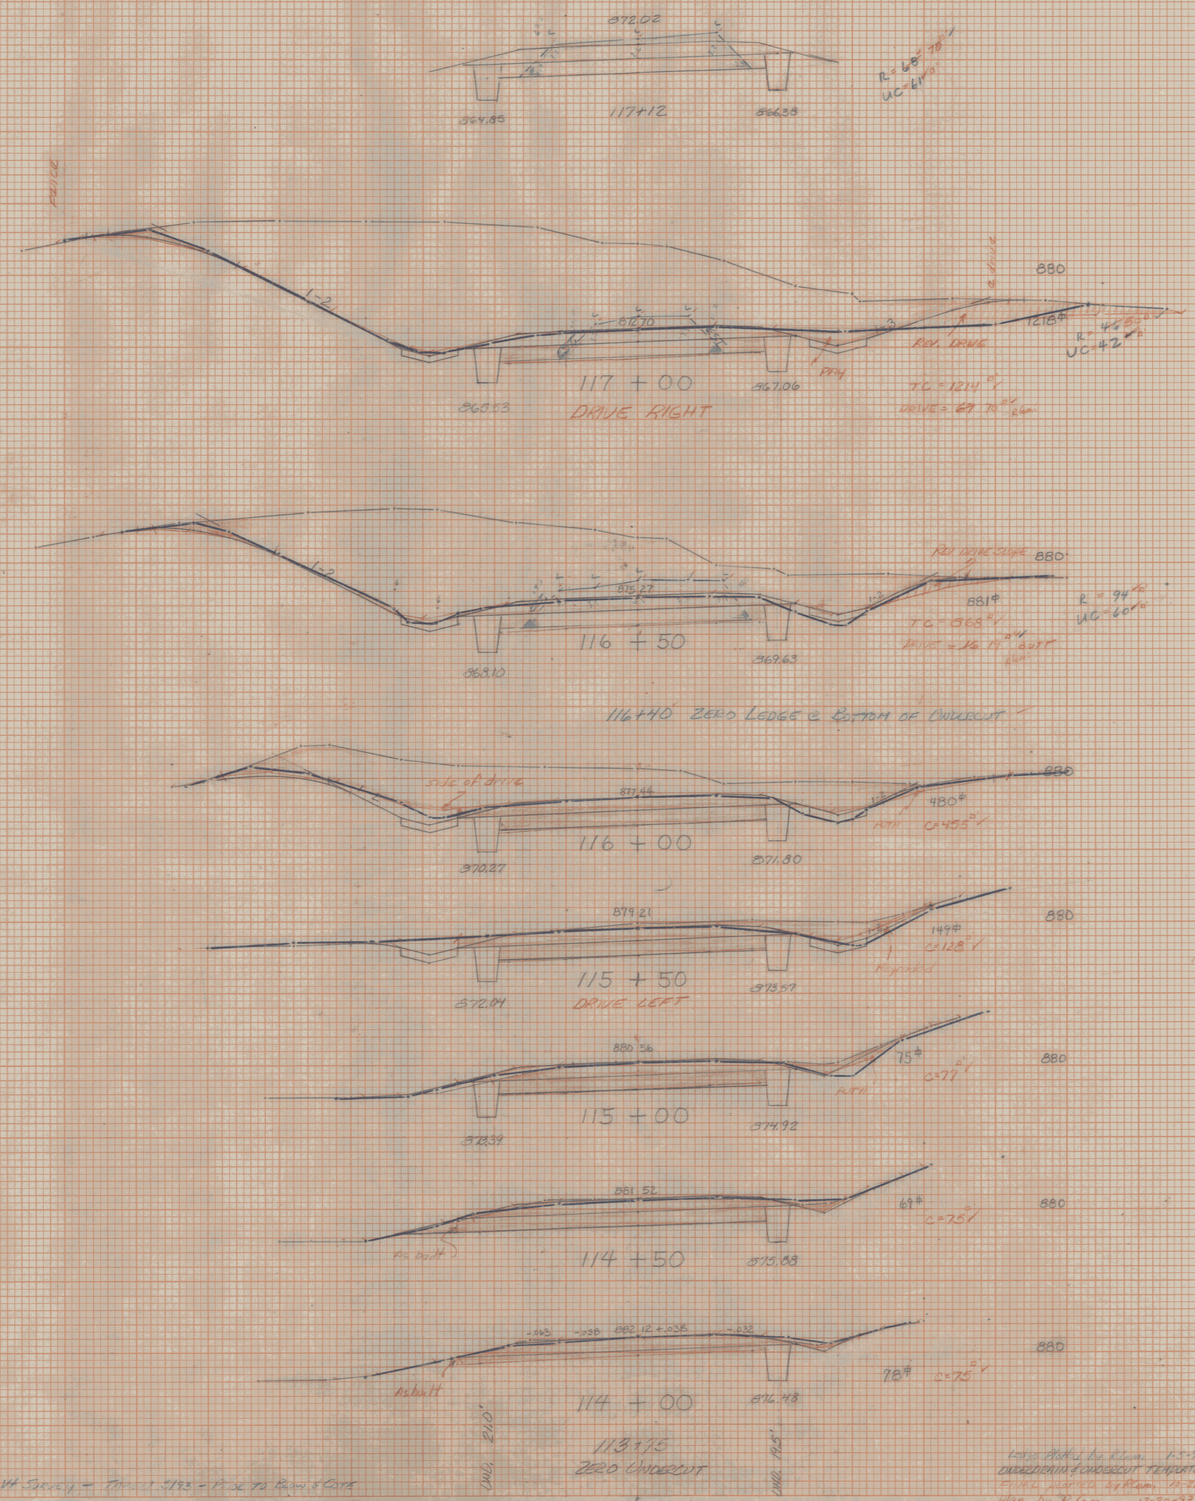

Base Plot by H. Seely – Trans. Stg. – Plot to Rem's Cite

Cross Plots by R.Lam. 1-5-93
CHOKECUTS & CHOKECUT REVISED By RLam 1-5-93
Plots Checked by RLam. 12-26-93
Plan by K.Lam 12-20-93
Of Plan. by C.E.Lane 1-28-94
Rev. R.Lam. 2-4-94

REV. SECTIONS
STA 114+00 ~ 117+00
EAST MONTPELIER
RSEGC RS0246(1)
SHEET 1A OF 17A

PLATE 3 CROSS SECTION O. P. R. & W. E. STANDARD
DIETZGEN CORPORATION

FINAL SURVEY — NOTE BOOK No. — SURVEYED — PLOTTED — TEMPLATE — AREAS — AREAS CHECKED — BY — DATE

ORIGINAL SURVEY — NOTE BOOK No. — SURVEYED TAC, RRC 11-26-91 — PLOTTED TAC 12-26-91 — TEMPLATE TAC — AREAS TAC — AREAS CHECKED TAC

147xs