

FINAL SURVEY NOTE BOOK No. _____

DATE _____

BY _____


REVISIONS
 PLOTTED _____
 TEMPLATE _____
 AREA CHECKED _____

ORIGINAL SURVEY NOTE BOOK No. _____

DATE _____

BY _____

REVISIONS
 PLOTTED _____
 TEMPLATE _____
 AREA CHECKED _____

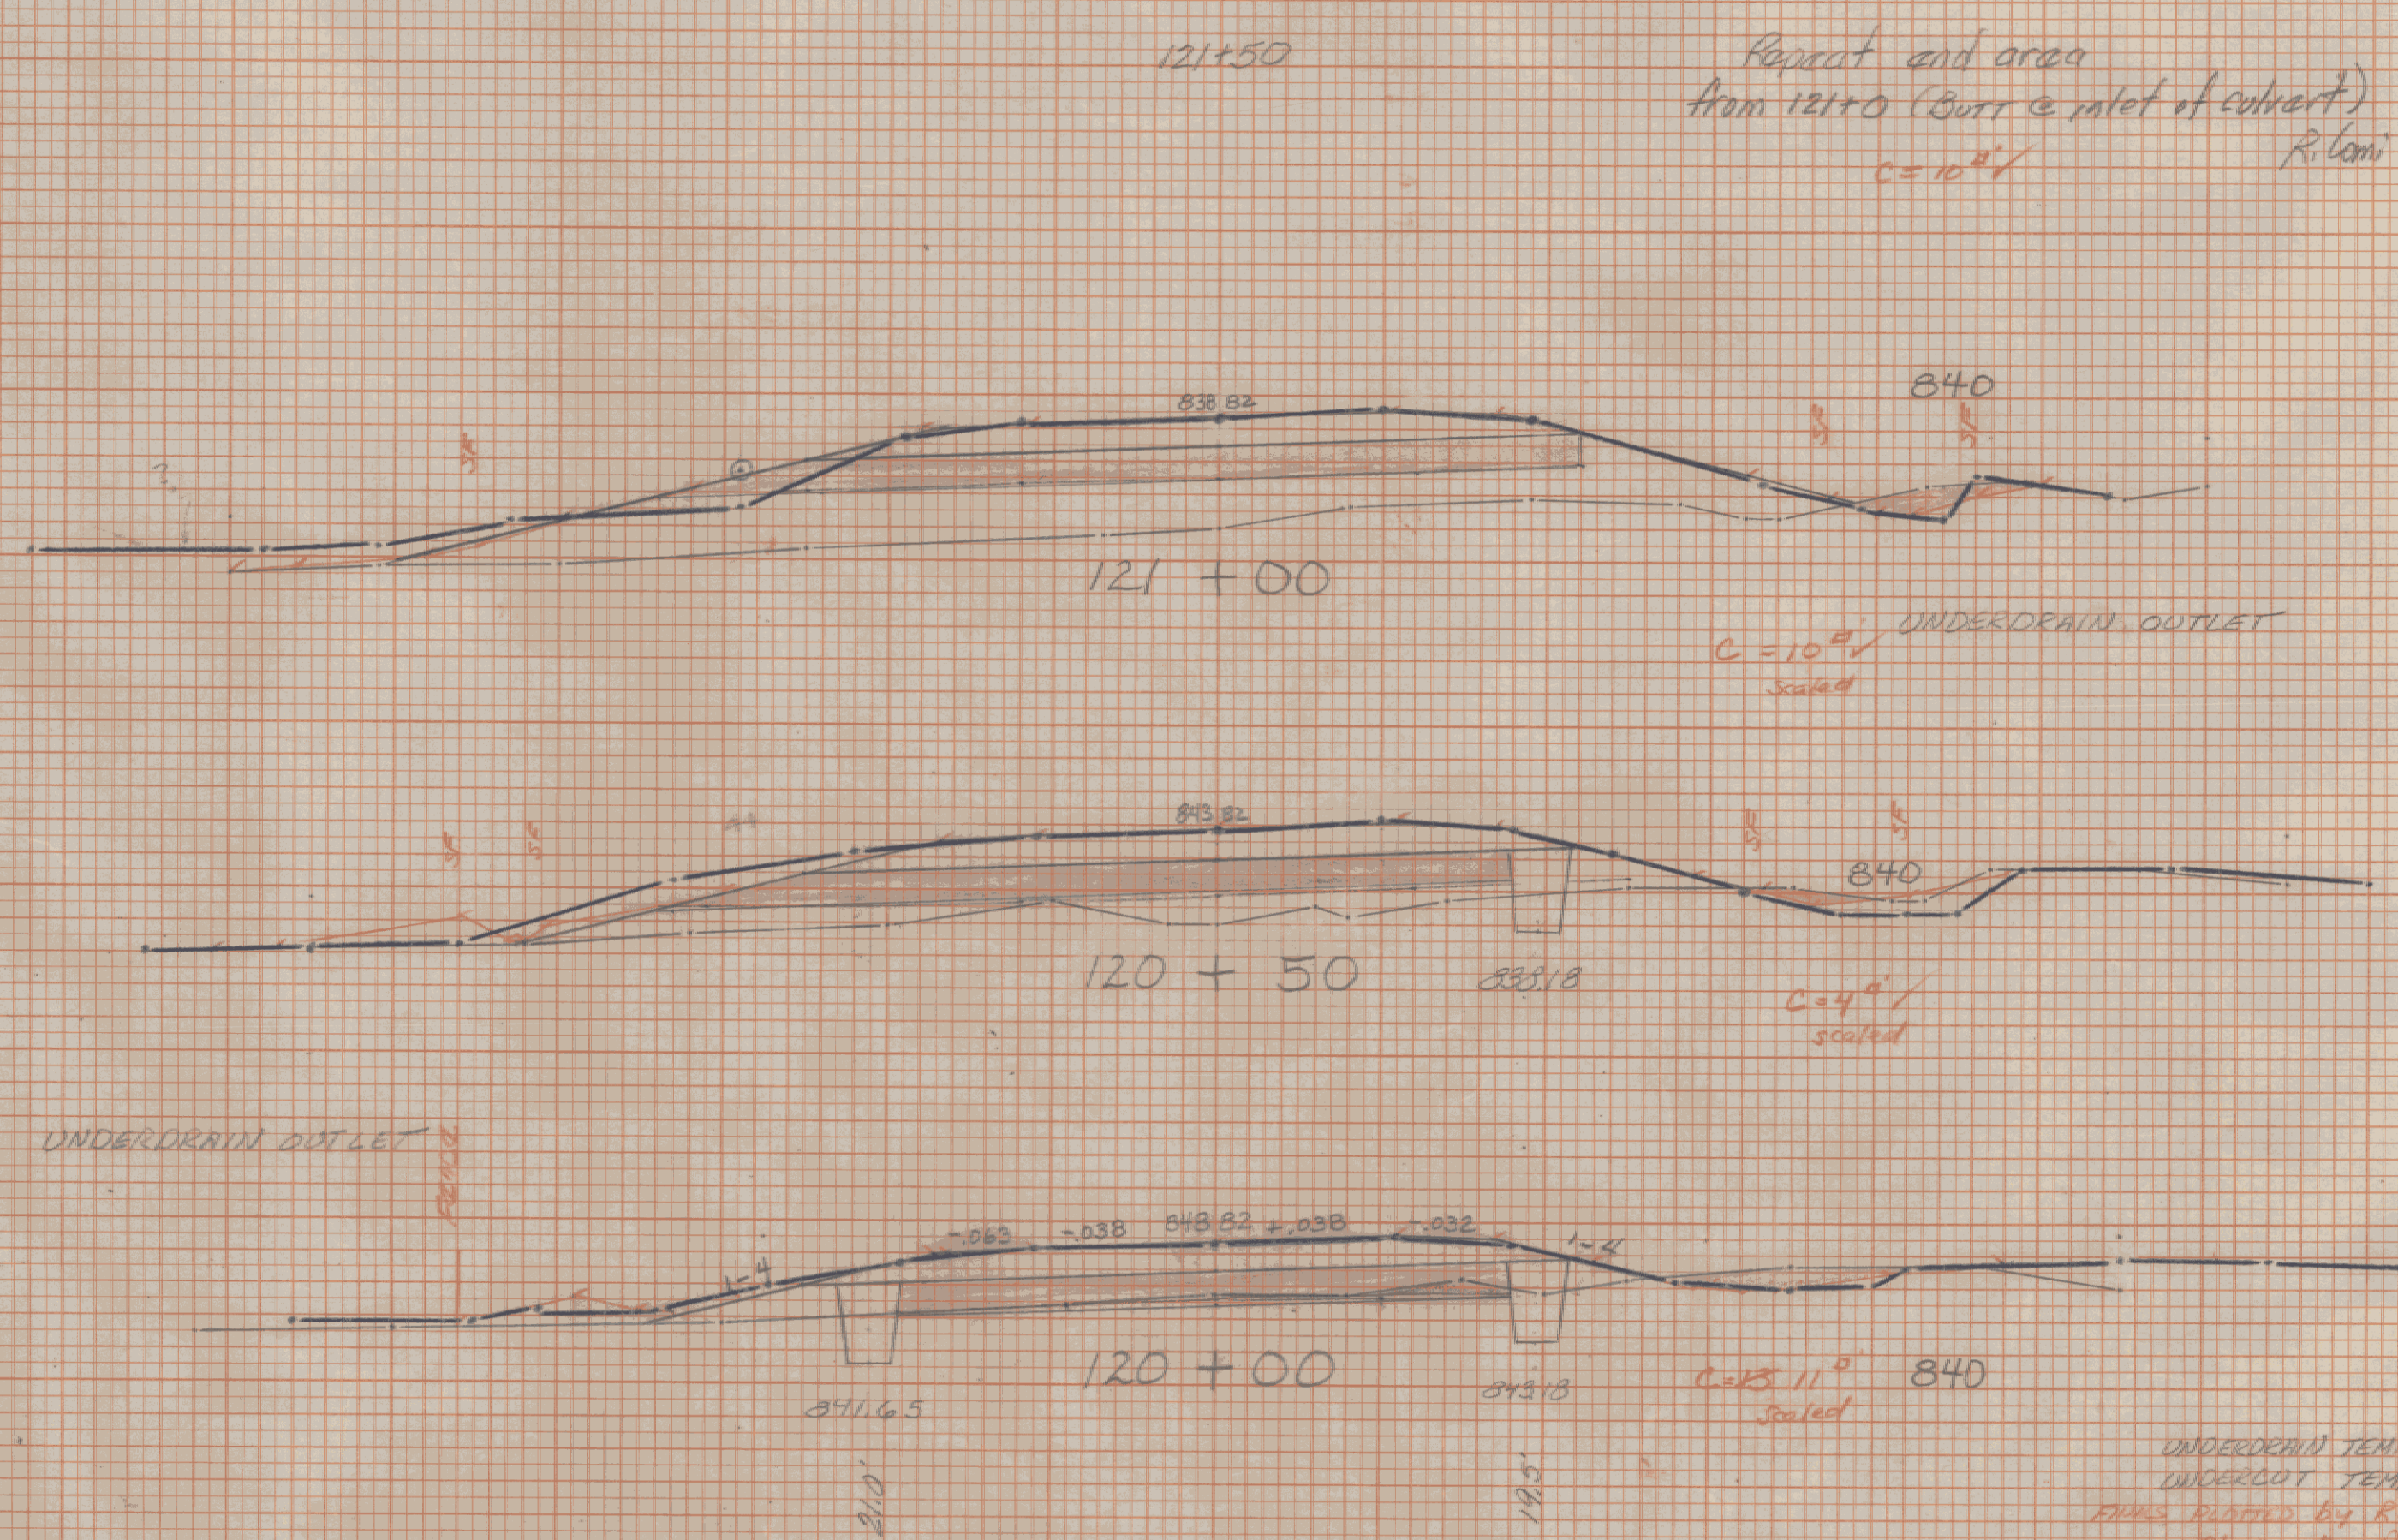


PLATE 3 CROSS SECTION O. P. & E. STANDARD
 DETZEN CORPORATION

REV. SECTIONS
 STA 120+00 ~
 EAST MONTPELIER
 RSEGC R50246(1)
 SHEET 3A OF 17A