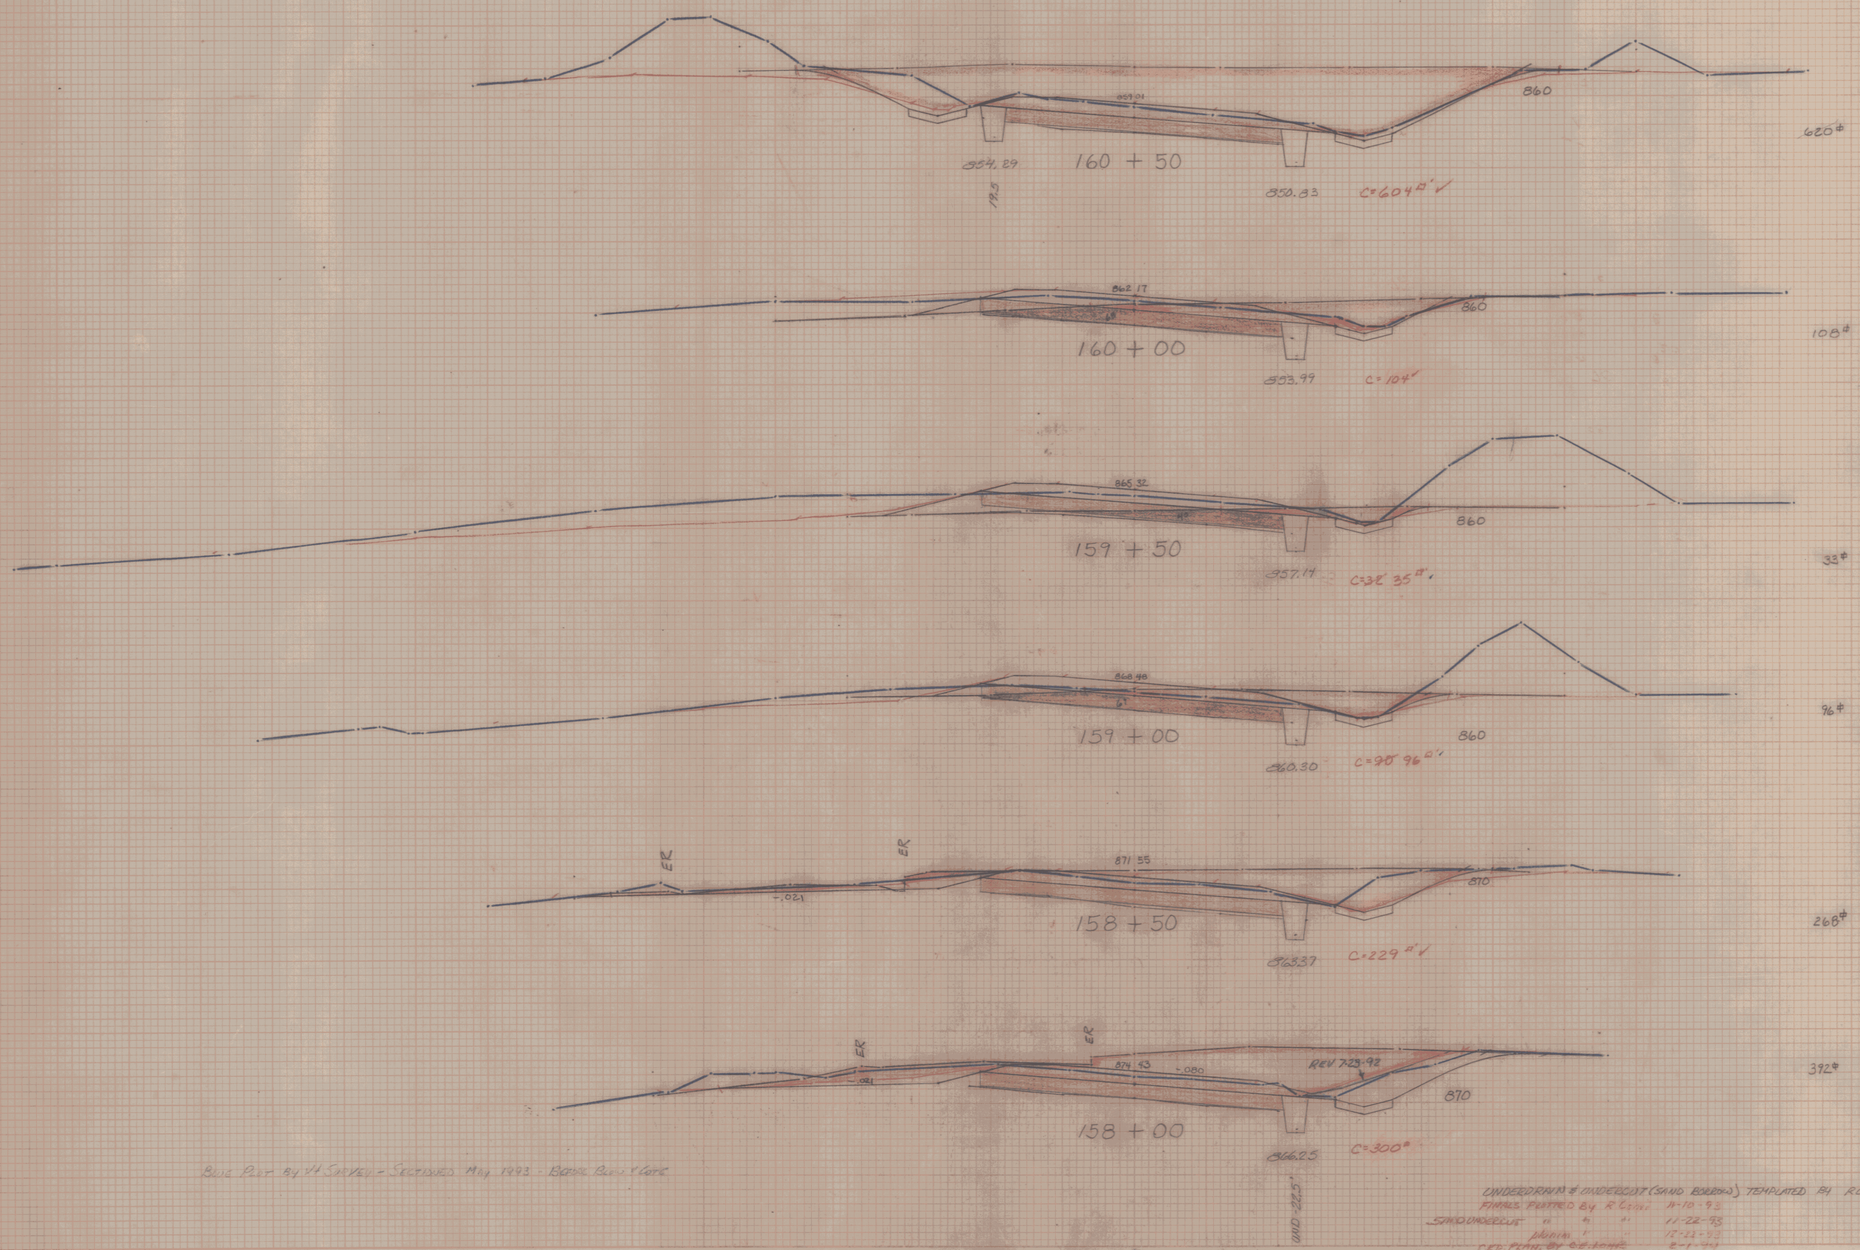

Blue Print By VT Survey - Sections May 1993 - Blue Print Work

UNDERDRAIN & UNDERCUT (SAND BORROW) TEMPLATED BY R.Lam 1-6-93
FINALS PLOTTED BY R.Lam 11-10-93
SAND UNDERCUT " " " 11-22-93
plotted 12-22-93
CES: PLOTTED BY R.Lam 8-1-94
R.Lam 2-4-94

REV. SECTIONS
STA 158+00 ~ 160+50
EAST MONTPELIER
RSEGC RS 0246 (1) SA
SHEET 8A OF 17A

154+5

Keuffel & Esser Company. PLATE 3, CROSS SECTION 487056. Made in U.S.A.