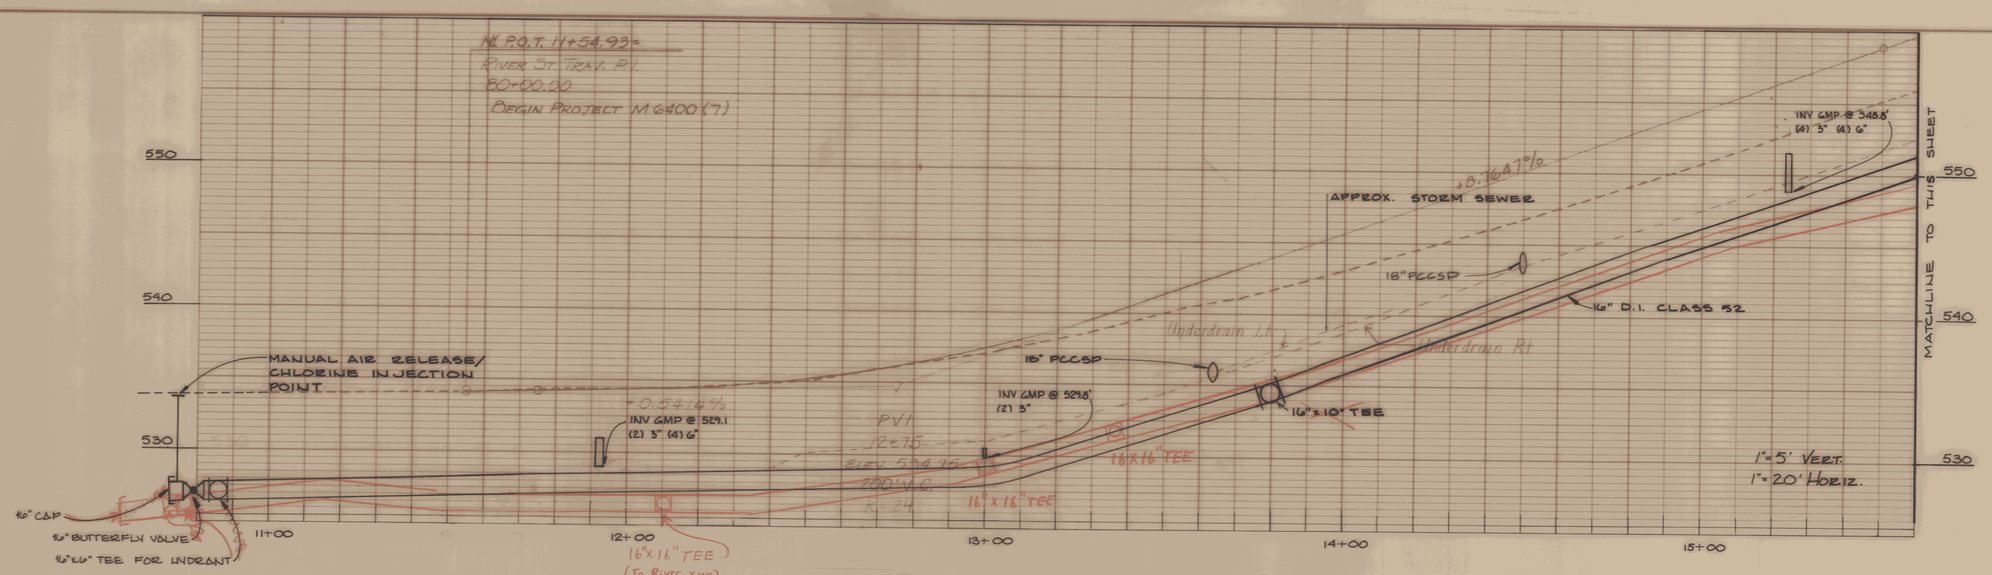

PROFILE

SCALE: HORZ. 1"=20'
VERT. 1"=5'

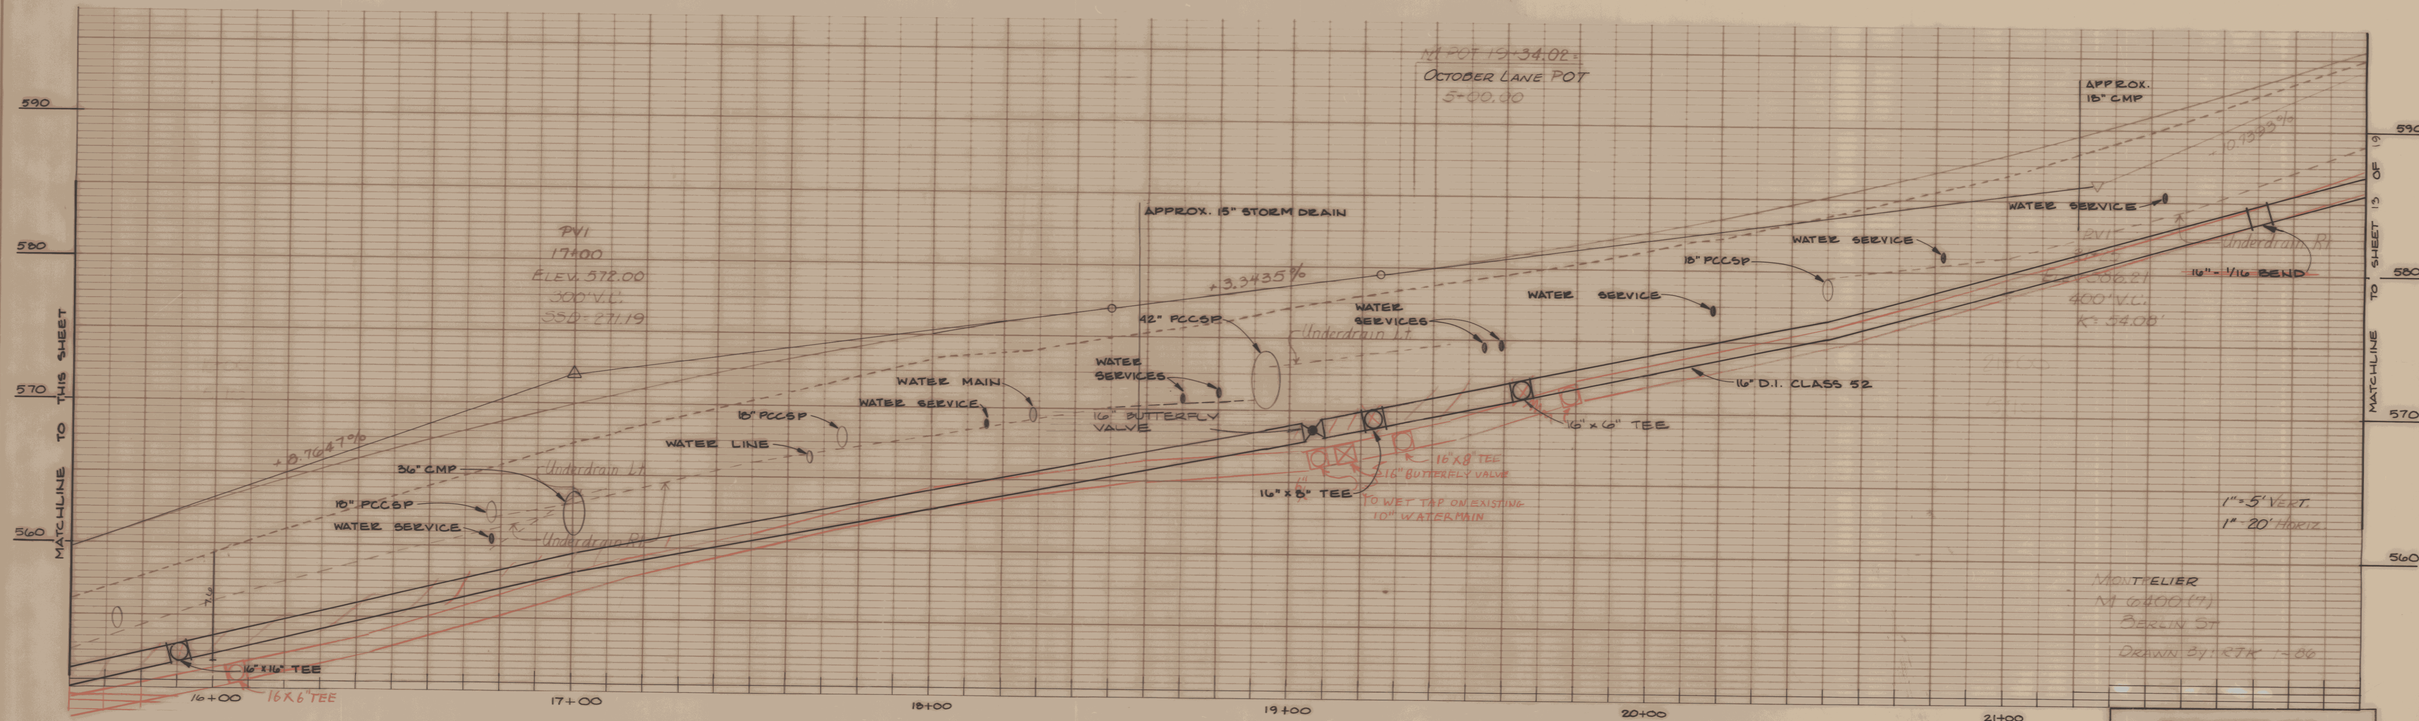

PROFILE

SCALE: HORZ. 1"=20'
VERT 1"=5'

THIS SHEET FOR UTILITIES USE ONLY

Rev.	Description	By	Date
2	LOCATE GMP DUCTS	AWH	1-3-91
1	EXTEND MAIN @ 11+00	KEF	7-24-90

STATE OF VERMONT
THOMAS D. HENRY
REGISTERED ENGINEER

SHEET 84 OF 335

CITY OF MONTPELIER

BERLIN STREET RESTORATION
WATER MAIN PROFILE

MONTPELIER, VERMONT

Dufresne-Henry
58 East State Street
Montpelier, VT 05602

Client No. 618040 | Proj. Mgr. TDH | Date 4-14-89 | B | No. 12

BRUNING 44 232 7435?