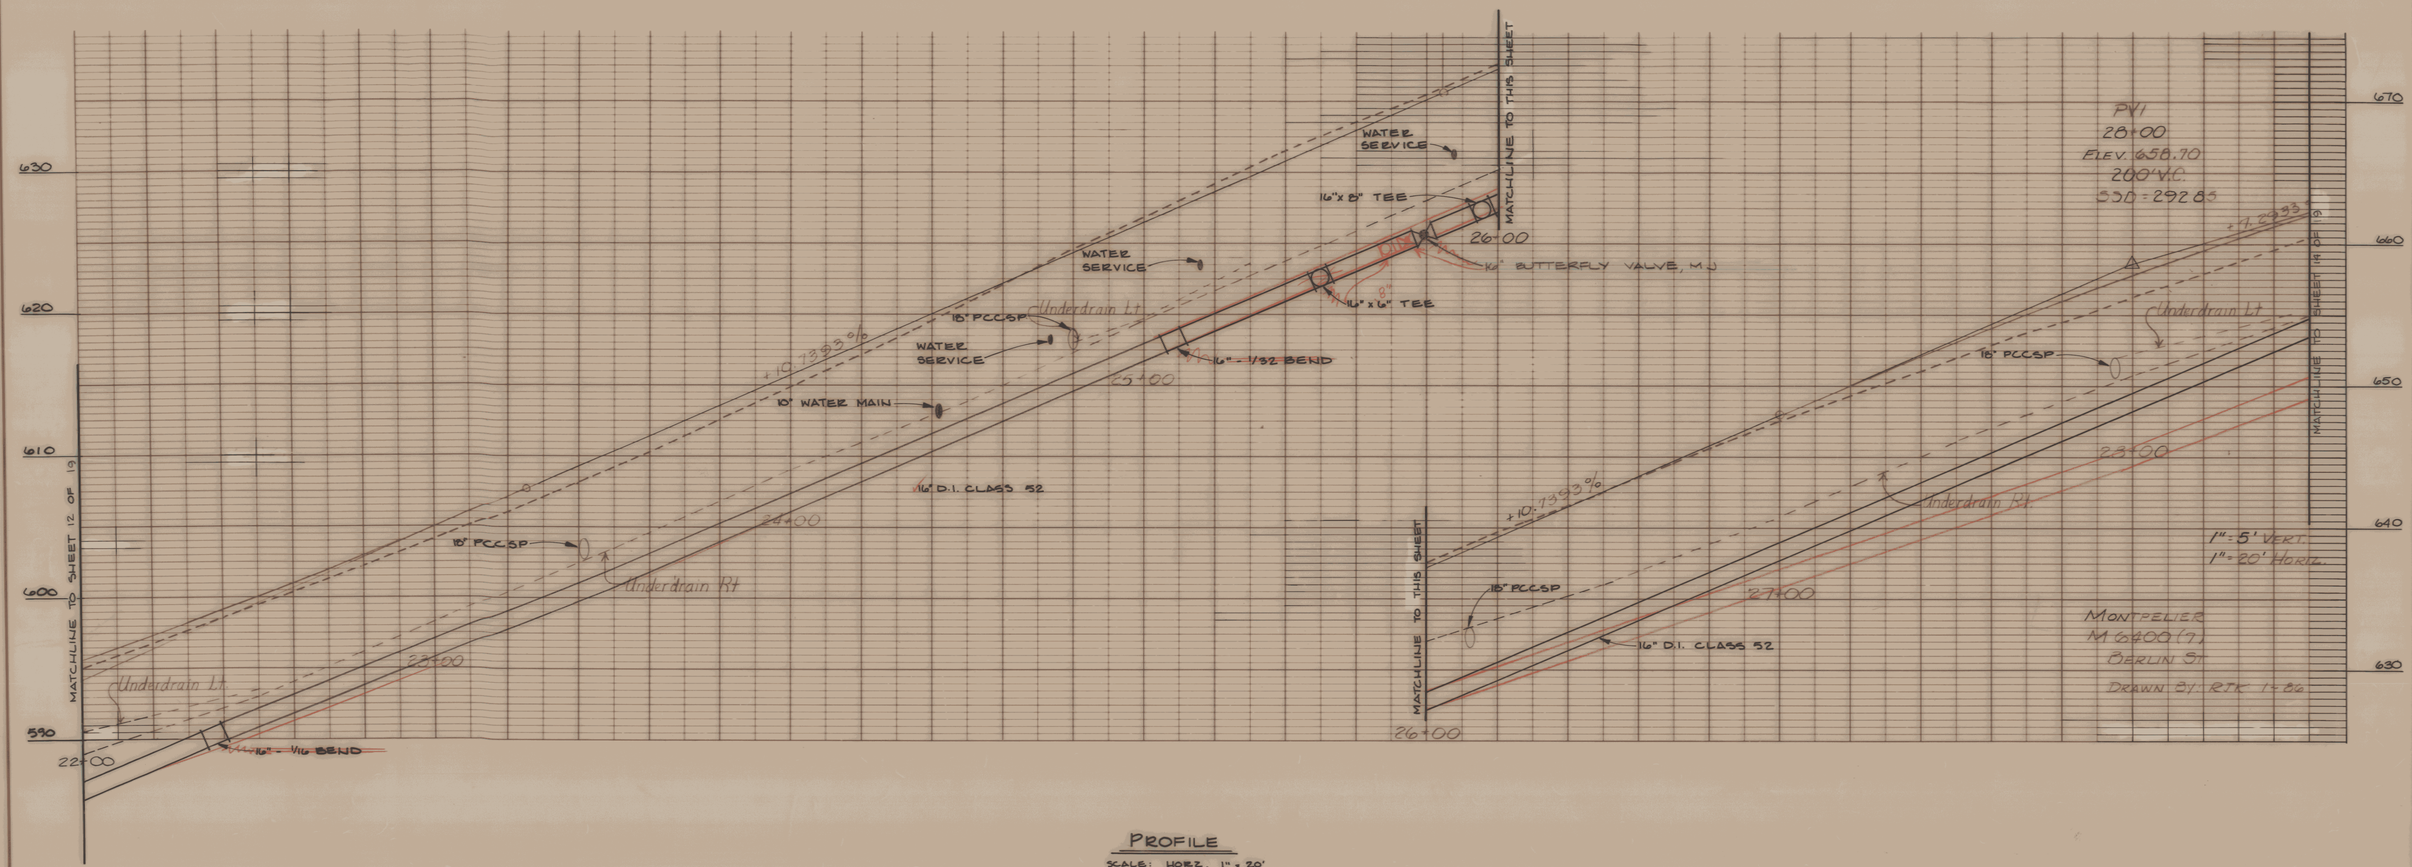

PROFILE

SCALE: HORZ. 1" = 20'
VERT. 1" = 5'

THIS SHEET FOR UTILITIES USE ONLY

SHEET 86 OF 335

Dufresne-Henry
58 East State Street
Montpelier, VT 05602

CITY OF MONTPELIER
BERLIN STREET RESTORATION
WATER MAIN PROFILE
MONTPELIER, VERMONT

Client No. 618040 | Proj. Mgr. T.D.N. | Date 4-14-89 | E | No. 13

BRUNING 44 232 74357