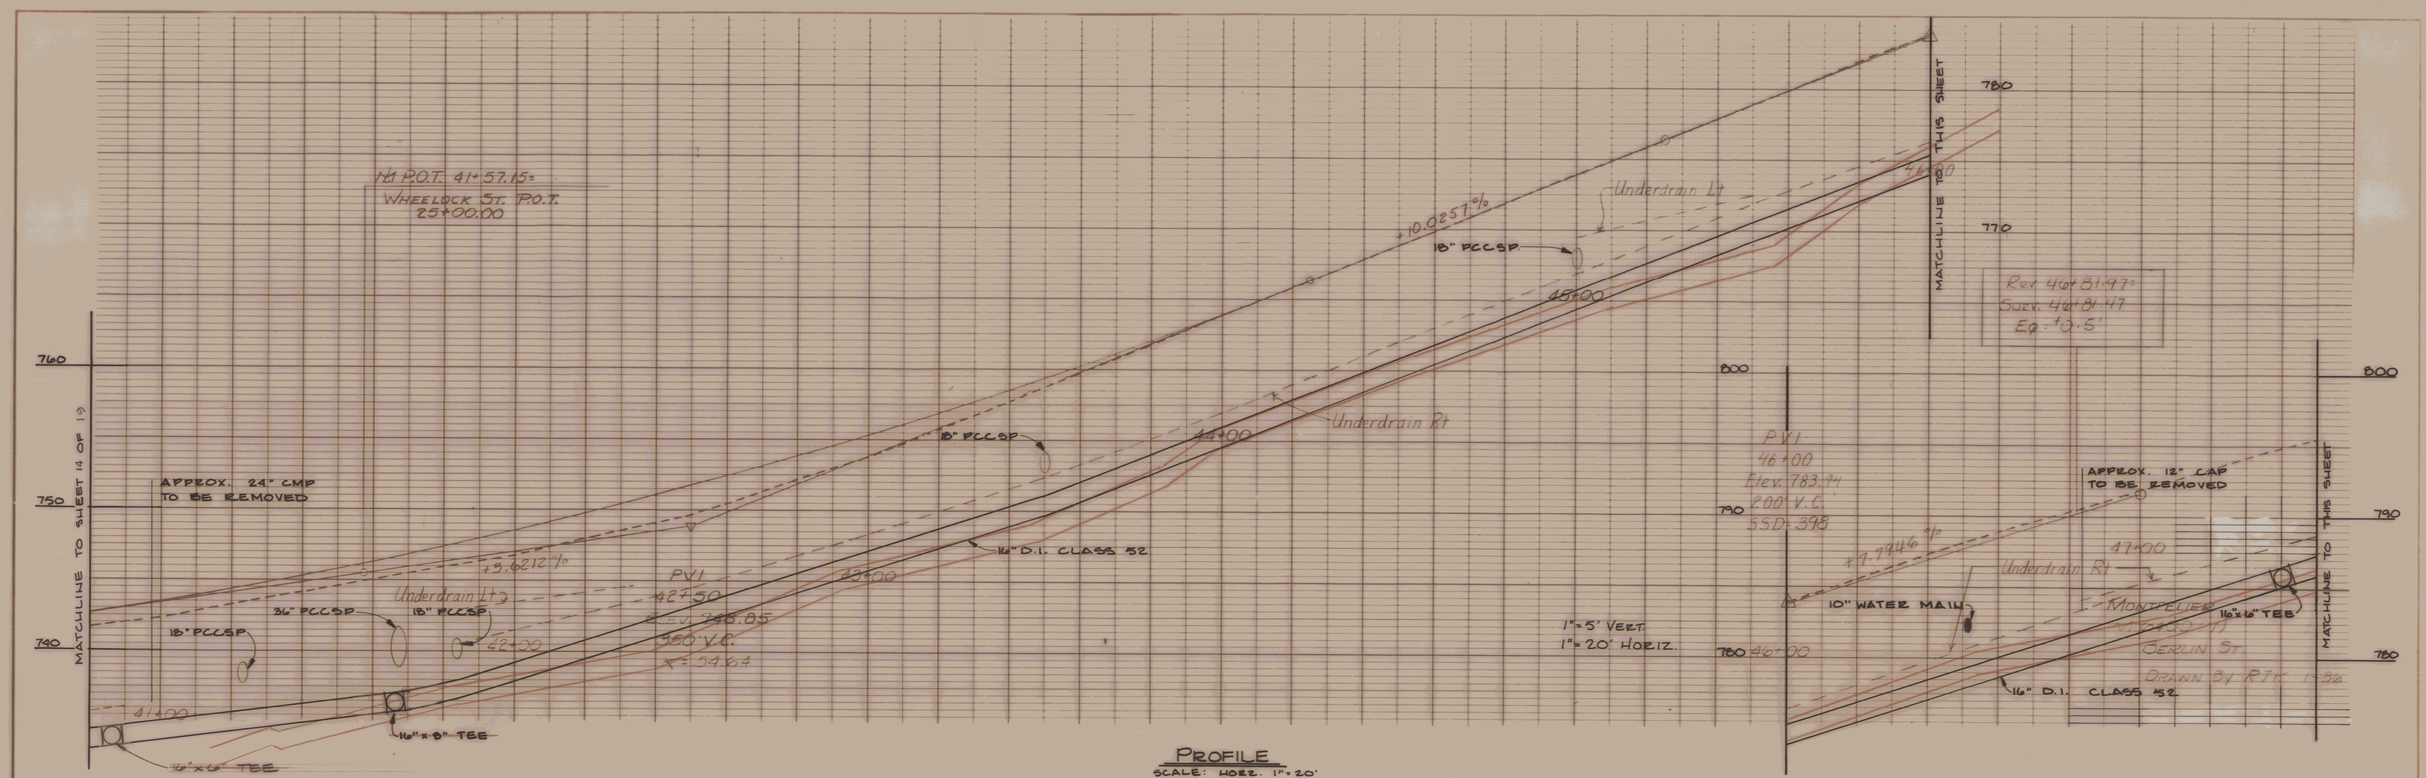

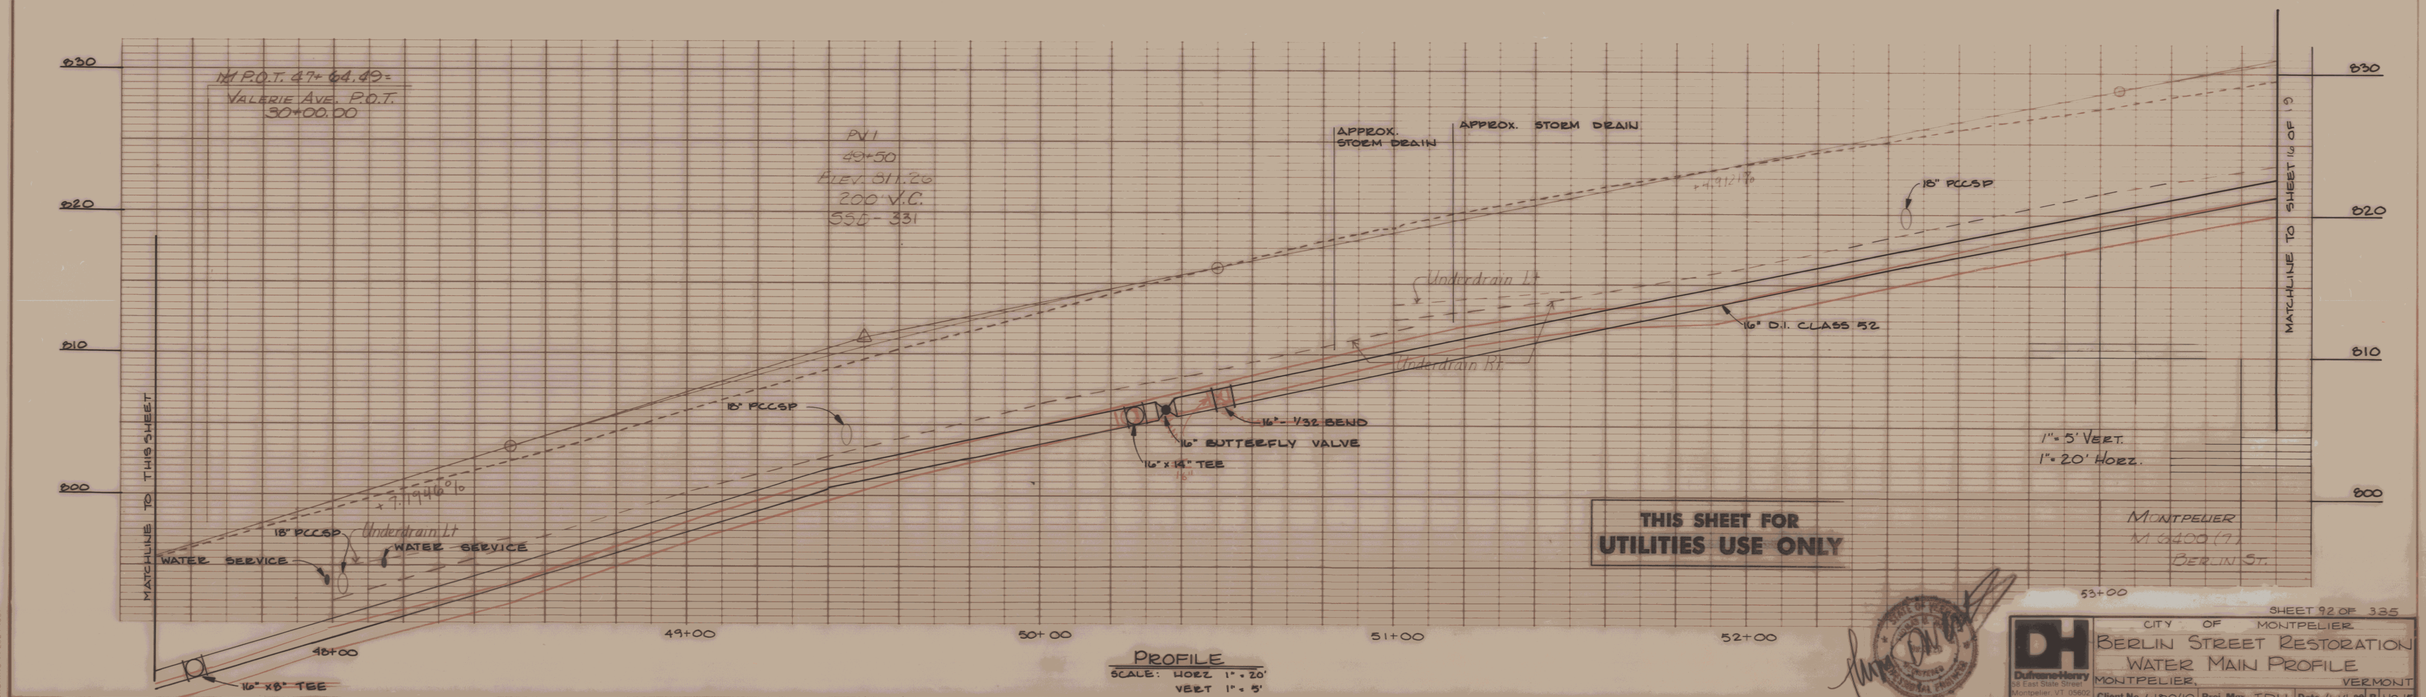

SHEET 92 OF 335

CITY OF MONTPELIER

BERLIN STREET RESTORATION
WATER MAIN PROFILE

MONTPELIER, VERMONT

DufresneHenry
38 East State Street
Montpelier, VT 05602

Client No. 61D040	Proj. Mgr. TDN	Date 4-14-93	B	No. 15

BRUNING 24 22 7 4397