

DURABLE 4" WHITE LINE
 33+22, 9' LT. ~ 34+06, 9' LT.
 33+22, 9' LT. ~ 17' LT.
 33+42, 9' LT. ~ 17' LT.
 33+64, 9' LT. ~ 17' LT.
 33+86, 9' LT. ~ 17' LT.
 34+06, 9' LT. ~ 17' LT.
 34+06, 9' LT. ~ 34+35, 17' LT.
 34+06 LT. ~ 34+30 LT. (DIAG.)
 34+96, 17' LT. ~ 35+20, 9' LT.
 35+03 LT. ~ 35+20 LT. (DIAG.)
 35+20, 9' LT.
 35+20, 9' LT. ~ 17' LT.
 35+40, 9' LT. ~ 17' LT.
 35+80, 9' LT. ~ 36+20, 9' LT.
 35+80, 9' LT. ~ 17' LT.
 36+00, 9' LT. ~ 17' LT.
 36+20, 9' LT. ~ 17' LT.
 36+60, 9' LT. ~ 37+00, 9' LT.
 36+60, 9' LT. ~ 17' LT.
 36+80, 9' LT. ~ 17' LT.
 37+00, 9' LT. ~ 17' LT.
 33+00 ~ 39+00 LT & RT
 BLODGET AVE. (177')

DURABLE 4" WHITE LINE CONT.
 37+37, 9' LT. ~ 37+77, 9' LT.
 37+37, 9' LT. ~ 17' LT.
 37+57, 9' LT. ~ 17' LT.
 37+77, 9' LT. ~ 17' LT.
 38+24, 9' LT. ~ 38+46, 9' LT.
 38+24, 9' LT. ~ 17' LT.
 38+46, 9' LT. ~ 17' LT.

DURABLE 24" STOP BAR
 SL 20+20-20+22 CL TO 13' LT.
 REMOVING SIGNS (MOD.)
 IEA.
 4" WHITE LINE
 33+00-39+00, 15' RT.

TEMPORARY CROSSWALK W/ DIAGONAL LINES (6')
 34+35-34+95, 17' TO 23' LT. (43')
DURABLE CROSSWALK W/ DIAGONAL LINES (6')
 34+35-34+95, 17' TO 23' LT.


TEMPORARY 4" YELLOW LINE
 33+00-34+35, 3' RT. (DBL.)
 34+90-39+00, 3' RT. (DBL.)
 33+00 ~ 34+15 C

4" YELLOW LINE
 33+00-34+35, 3' RT. (DBL.)
 34+90-39+00, 3' RT. (DBL.)
 SL 20+22-20+40 CL (DBL.)

TEMPORARY 24" STOP BAR
 BLODGET AVE. (15')

DURABLE LETTER OR SYMBOL
 33+55 LT (I)

DURABLE 4" YELLOW LINE
 33+00 ~ 39+00 C
 BLODGET AVE. (64')

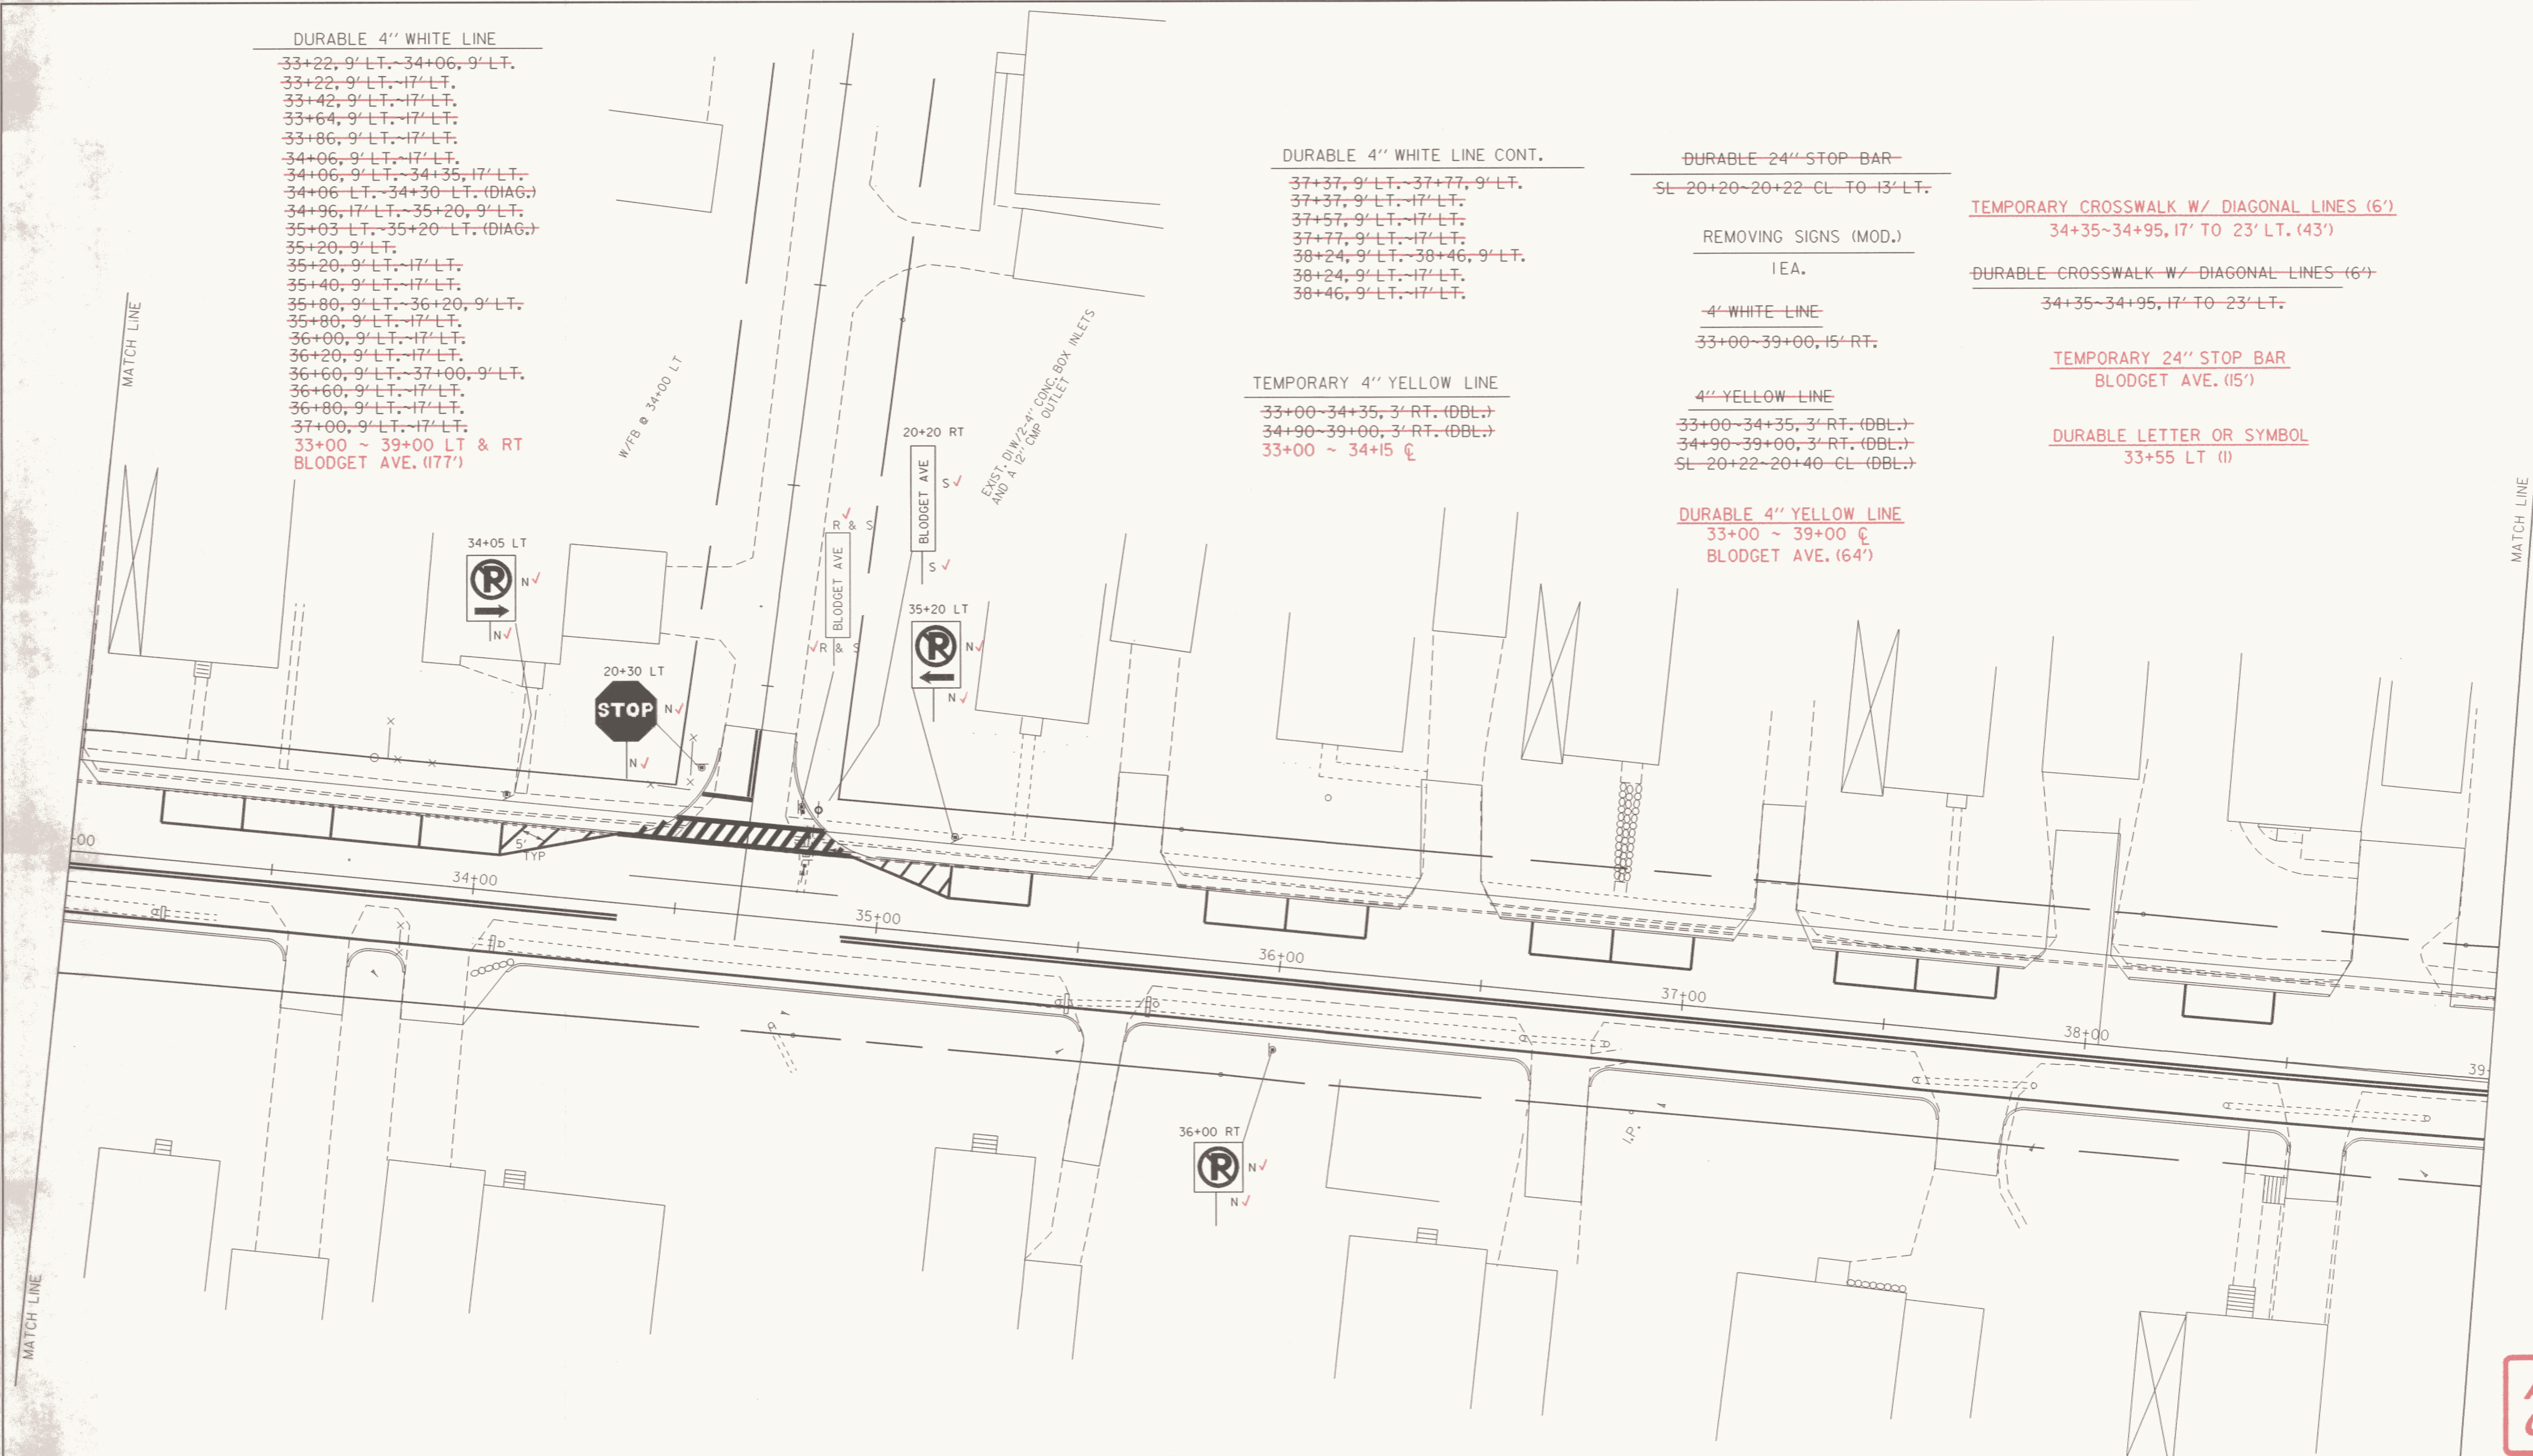

DATUM
 VERTICAL NGVD 1929
 HORIZONTAL N/A

**ARCHIVED
ON CADD**

SURVEYED BY MOREAU DATE 7-85
 DRAWN BY COTA/NAILOS DATE 4-88
 SQUAD LEADER SHERIDAN
 DESIGN FILE NO. ZG0: [50, 116] PETED. DGN: 1
 IPARM FILE PETEDS5.PRF DATE PLOTTED 16-FEB-1996
 PROJ. NAME MONTEPELIER
 PROJ. NO. MEGC M 6400(7)
 SHEET 117 OF 355 SHEETS