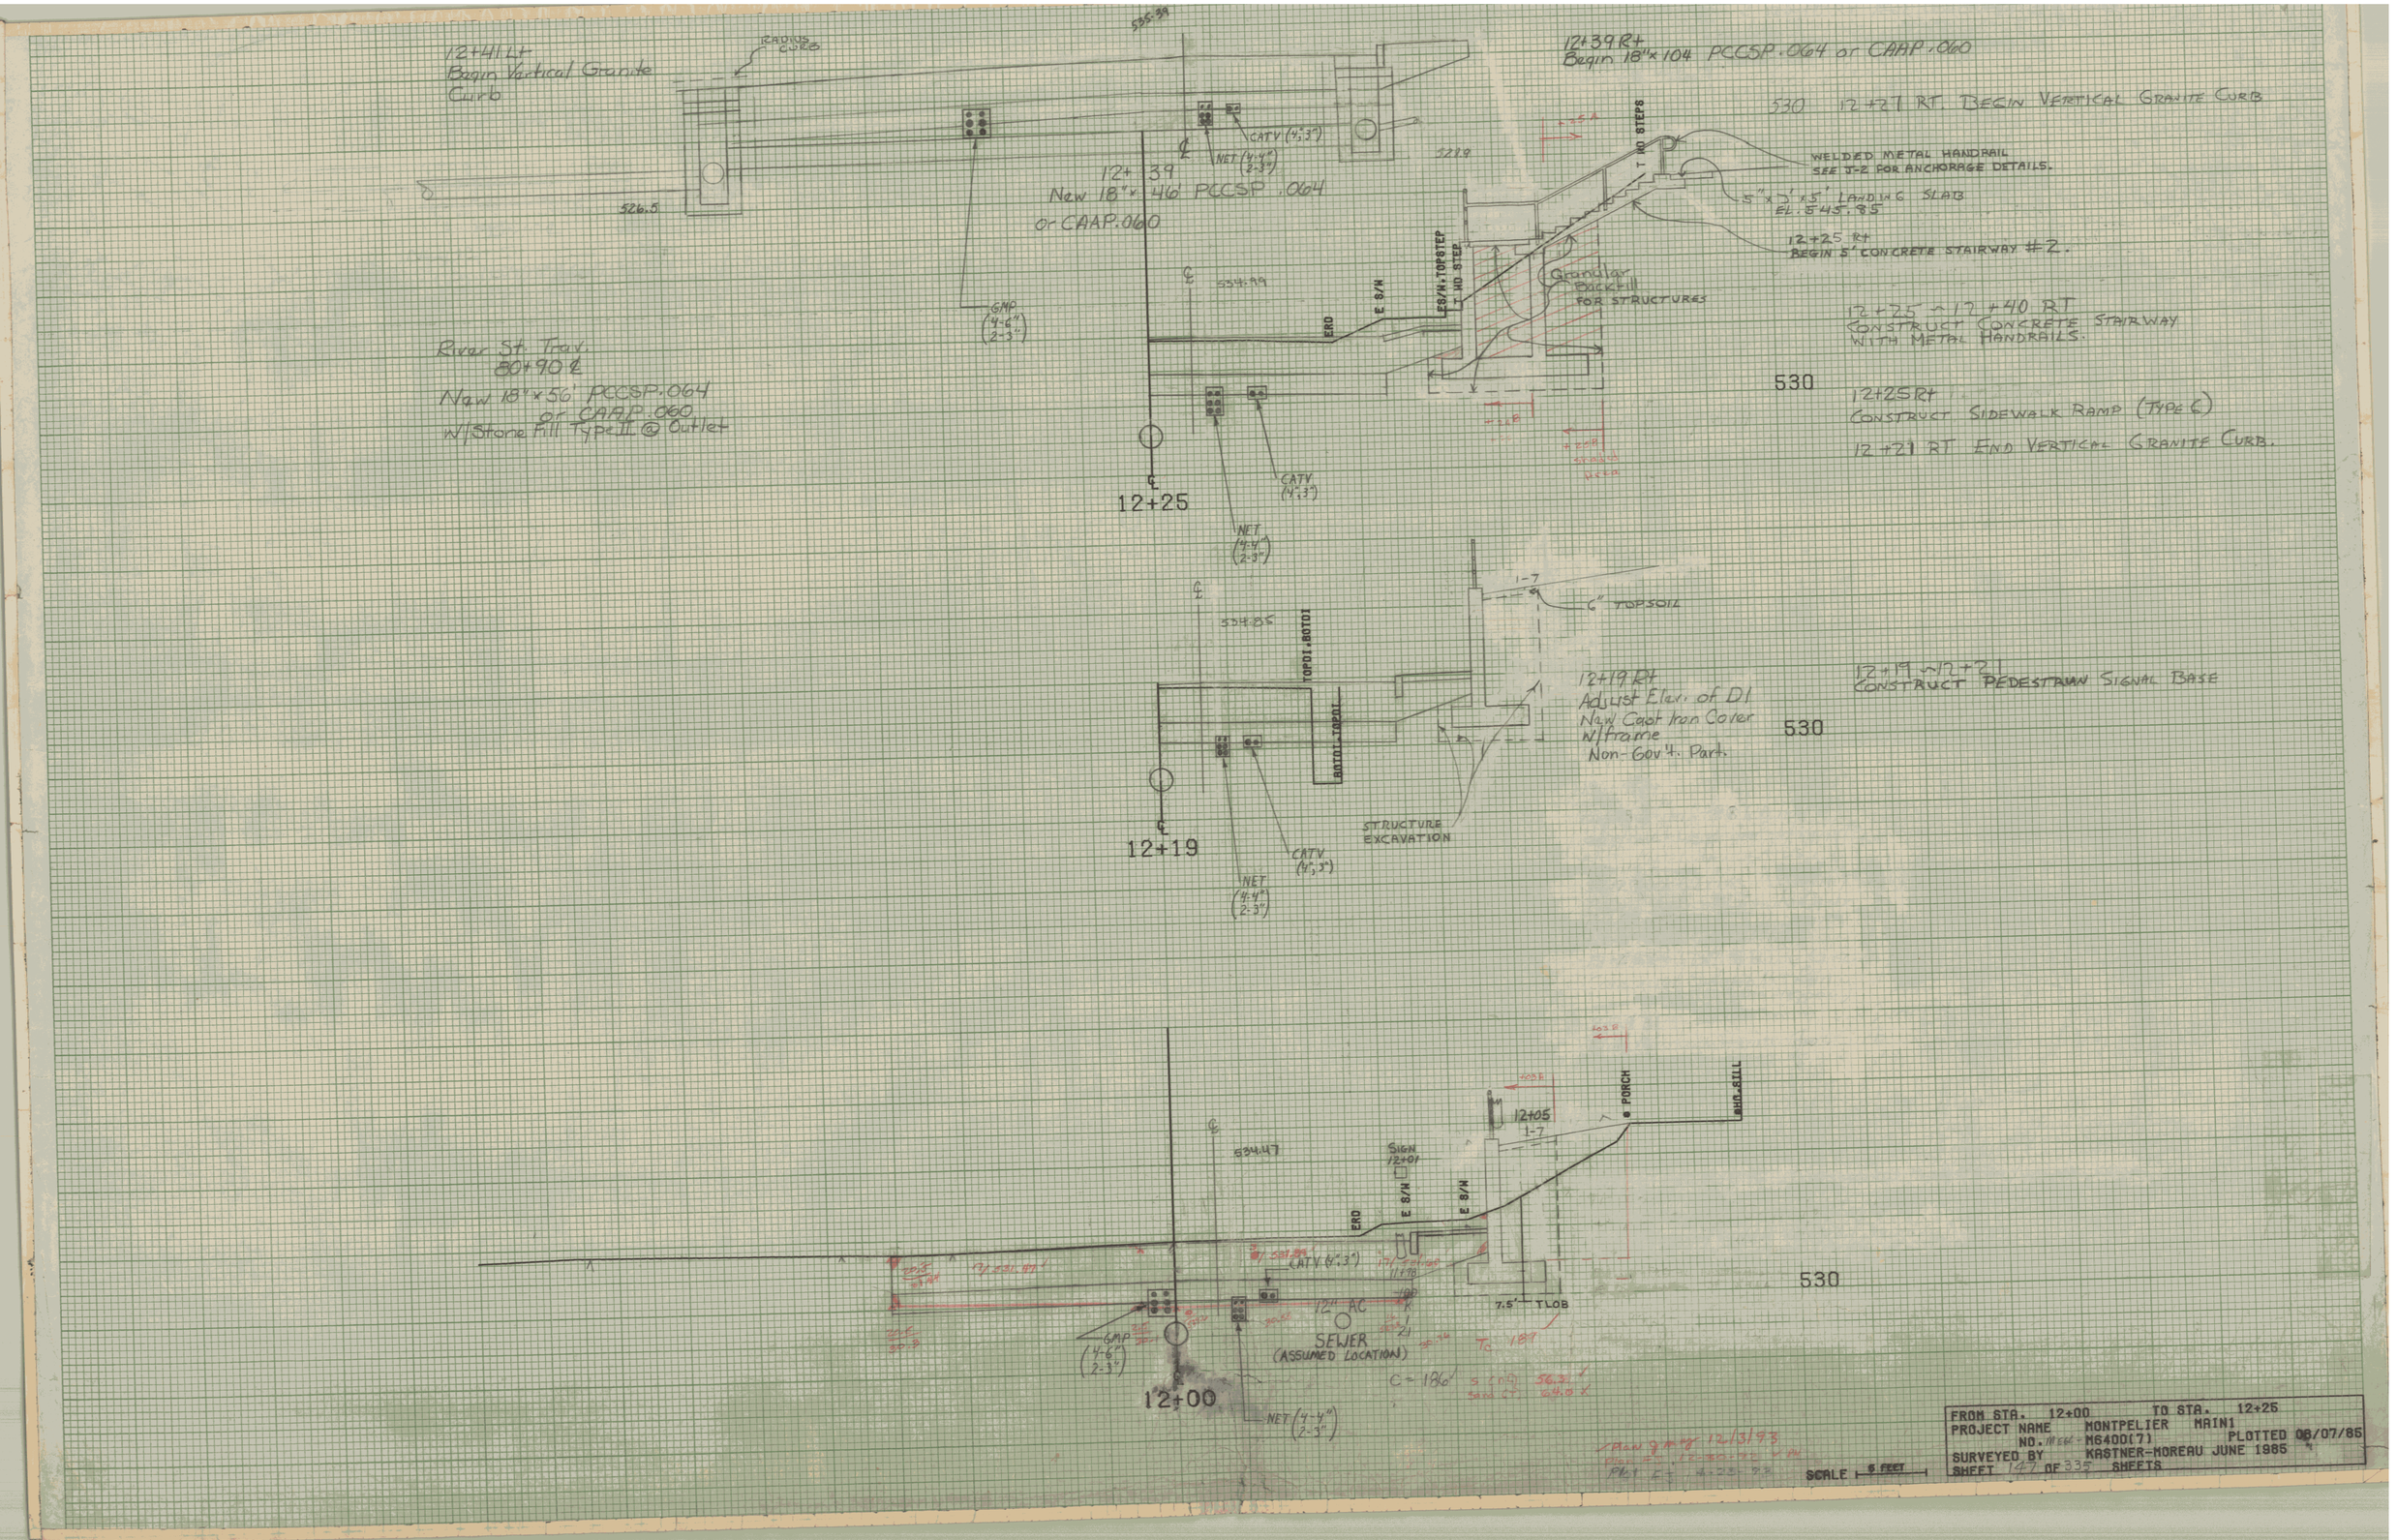
12+41 Lt
Begin Vertical Granite Curb
RADIUS CURB
555.99
526.5
CATV (4'-3")
NET (4'-4" 2'-3")
12+39
New 18" x 46' PCCSP .064
or CAAP.060
554.99
GMP (4'-6" 2'-3")
ERO
E S/H
LEG/W. TOP STEP
T NO STEP
River St. Trav.
50+90 ℄
New 18" x 56' PCCSP.064
or CAAP.060
W/Stone Fill Type II @ Outlet
12+25
CATV (4'-3")
NET (4'-4" 2'-3")
554.85
TOPOI. BOTOI
BOTOI. TOPOI
12+19
CATV (4'-3")
NET (4'-4" 2'-3")
12+39 Rt
Begin 18" x 104' PCCSP.064 or CAAP.060
T NO STEPS
Granular Backfill FOR STRUCTURES
530
12+21 RT. BEGIN VERTICAL GRANITE CURB
WELDED METAL HANDRAIL
SEE J-2 FOR ANCHORAGE DETAILS.
5' x 5' x 5' LANDING SLAB
EL. 545.85
12+25 Rt
BEGIN 5' CONCRETE STAIRWAY #2.
12+25 ~ 12+40 RT
CONSTRUCT CONCRETE STAIRWAY
WITH METAL HANDRAILS.
530
12+25 Rt
CONSTRUCT SIDEWALK RAMP (TYPE C)
12+21 RT END VERTICAL GRANITE CURB.
6" TOPSOIL
12+19 Rt
Adjust Elev. of DI
New Cast Iron Cover
W/Frame
Non-Gov't. Part.
STRUCTURE EXCAVATION
530
12+19 ~ 12+21
CONSTRUCT PEDESTRIAN SIGNAL BASE
555.47
SIGN 12+01
E S/H
E S/H
ERO
12+05
1-7
PORCH
BRD. SILL
(CATV (4'-3")
12" AC
SEWER
(ASSUMED LOCATION)
7.5' TLOB
GMP (4'-6" 2'-3")
12+00
NET (4'-4" 2'-3")
530
SCALE 5 FEET
FROM STA. 12+00 TO STA. 12+25
PROJECT NAME MONTPELIER MAIN1
NO. M6400(7) PLOTTED 08/07/85
SURVEYED BY KASTNER-MOREAU JUNE 1985
SHEET 147 OF 335 SHEETS