12+94 Rt
End Retaining Wall w/ metal hand rail
EXTEND UP DRIVE 20 Ft.
12+89 Rt
End Vertical Granite Curb.

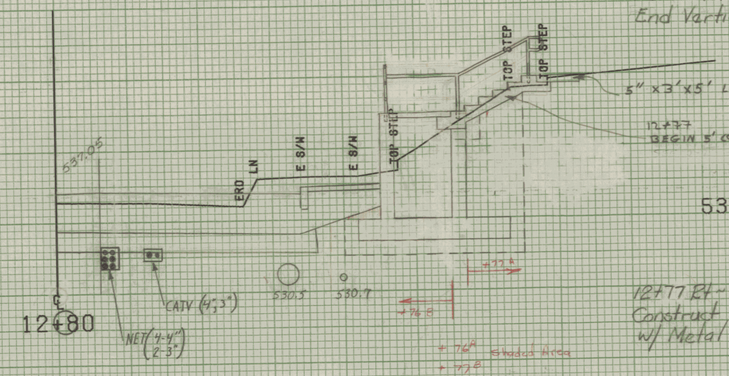

12+77 Rt ~ 12+90 Rt
Construct Concrete Stairway #3
w/ Metal Hand Rails.

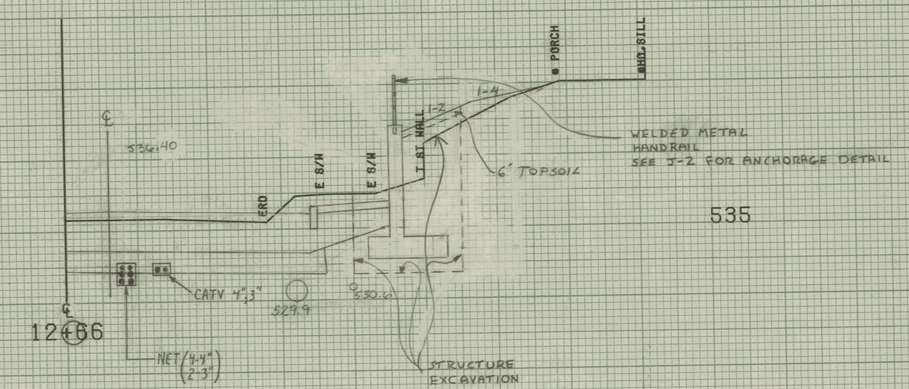

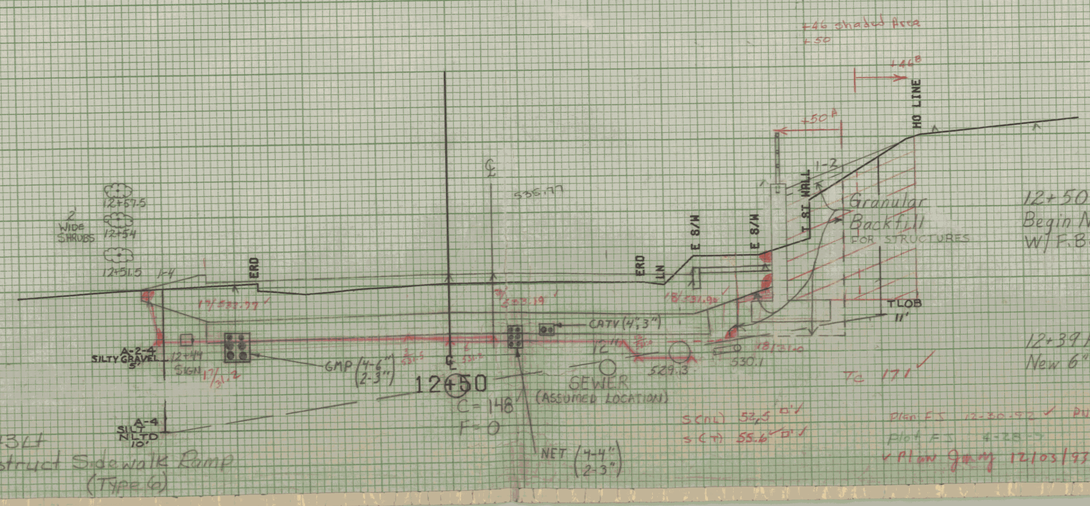

12+50 Rt
Begin New 6" x 445' Underdrain
W/ F.B. @ 16+95 Rt.

12+39 Rt ~ 12+50 Rt
New 6" x 10' Underdrain Carrier Pipe

12+43 Lt
Construct Sidewalk Ramp
(Type 6)

Scale 52.5 ✓
S(+) 55.6 ✓
Plan F.S. 12-20-93 ✓ PW
Plan F.S. 4-28-5
✓ Plan Grade 12/03/93

SCALE 5 FEET

FROM STA. 12+50	TO STA. 12+80
PROJECT NAME MONTPELIER	MAIN1
NO. M EGC-M6400(7)	PLOTTED 08/07/86
SURVEYED BY KASTNER-MOREAU	JUNE 1985
SHEET 142 OF 335 SHEETS	