16+77 Lt ~ 19+09 Rt
Remove Existing 36" CMP & 2'x2' DI

16+88
End Vertical
Granite Curb

16+77 Lt
Begin New 48" x 96' PCCSP 0.109 or
CAAP 0.105

MATCH LINE See Sheet 203

Note:
For details of the remainder
of this system see sheet 158

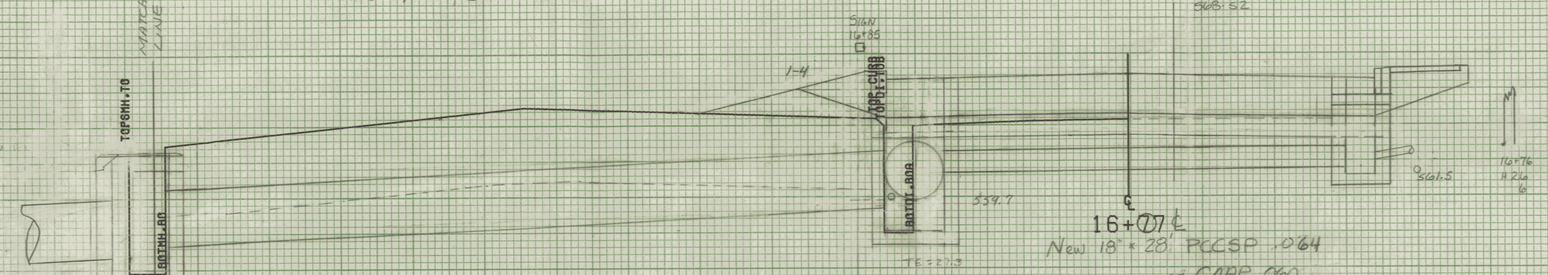


16+07 ℄
New 18" x 28' PCCSP .064
or CAAP .060

565

2' MAPLE
16+88

16+77 Rt
Begin 6" x 24" Underdrain Carrier Pipe

16+77 Lt
New 48" x 50' PCCSP .109 or
CAAP 0.105 WITH CCB

16+77 Lt ~ River St. Trav 85+07 Rt.
New 48" x 136' PCCSP (.109)
or CAAP (.105)

REMOVE EXISTING 36" CGMP + D.I.
BEGIN NEW 6" x 50' UNDERDRAIN w/ F.B. @ 17+21 Lt.
16+77 Lt ~ 17+16 Rt

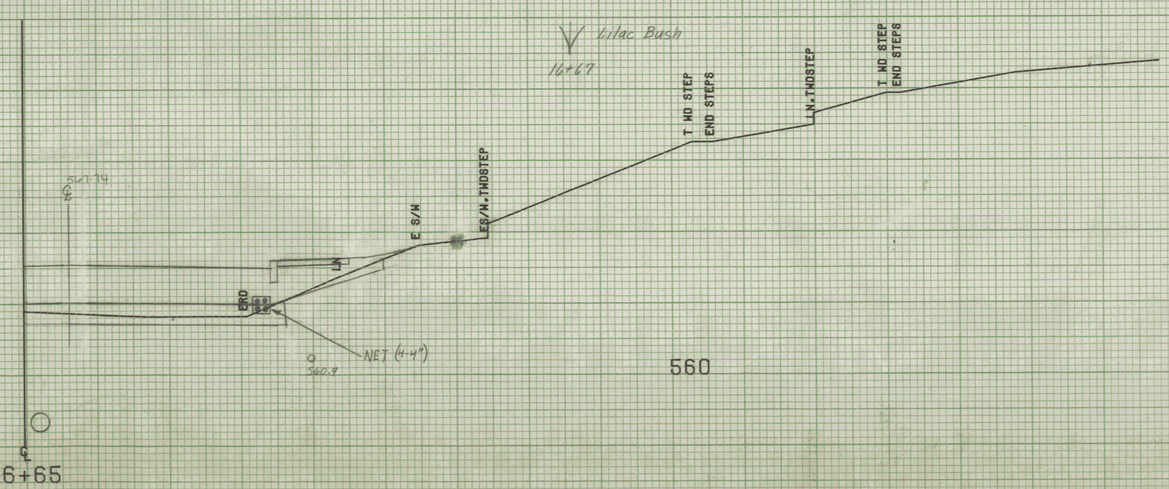


16+65

560

| | | |
|---|---|---|
| FROM STA. 16+65 | TO STA. 16+77 | |
| PROJECT NAME MONTPELIER MAIN1 | | |
| NO. M6400(7) | | PLOTTED 08/07/85 |
| SURVEYED BY KASTNER-MOREAU JUNE 1985 | | |
| SHEET 157 OF 335 SHEETS | | |

SCALE 5 FEET