17+45.5 Rt
Remove existing 1.5' x 1.5' DI

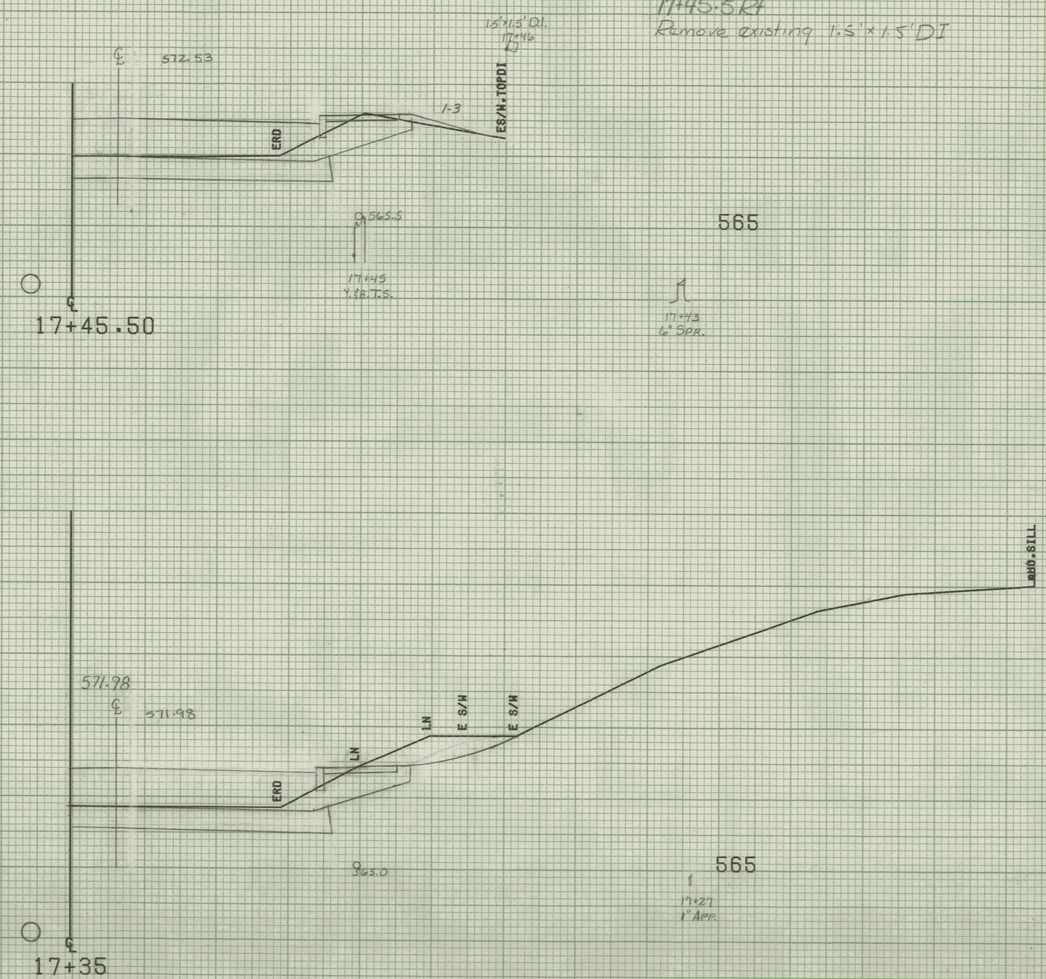

FROM STA. 17+35	TO STA. 17+45.50
PROJECT NAME MONTPELIER MAIN1	
NO. ~~HEM-~~ M6400(7)	PLOTTED 08/07/86
SURVEYED BY KASTNER-MOREAU JUNE 1986	
SHEET 160 OF 335 SHEETS	

SCALE 5 FEET