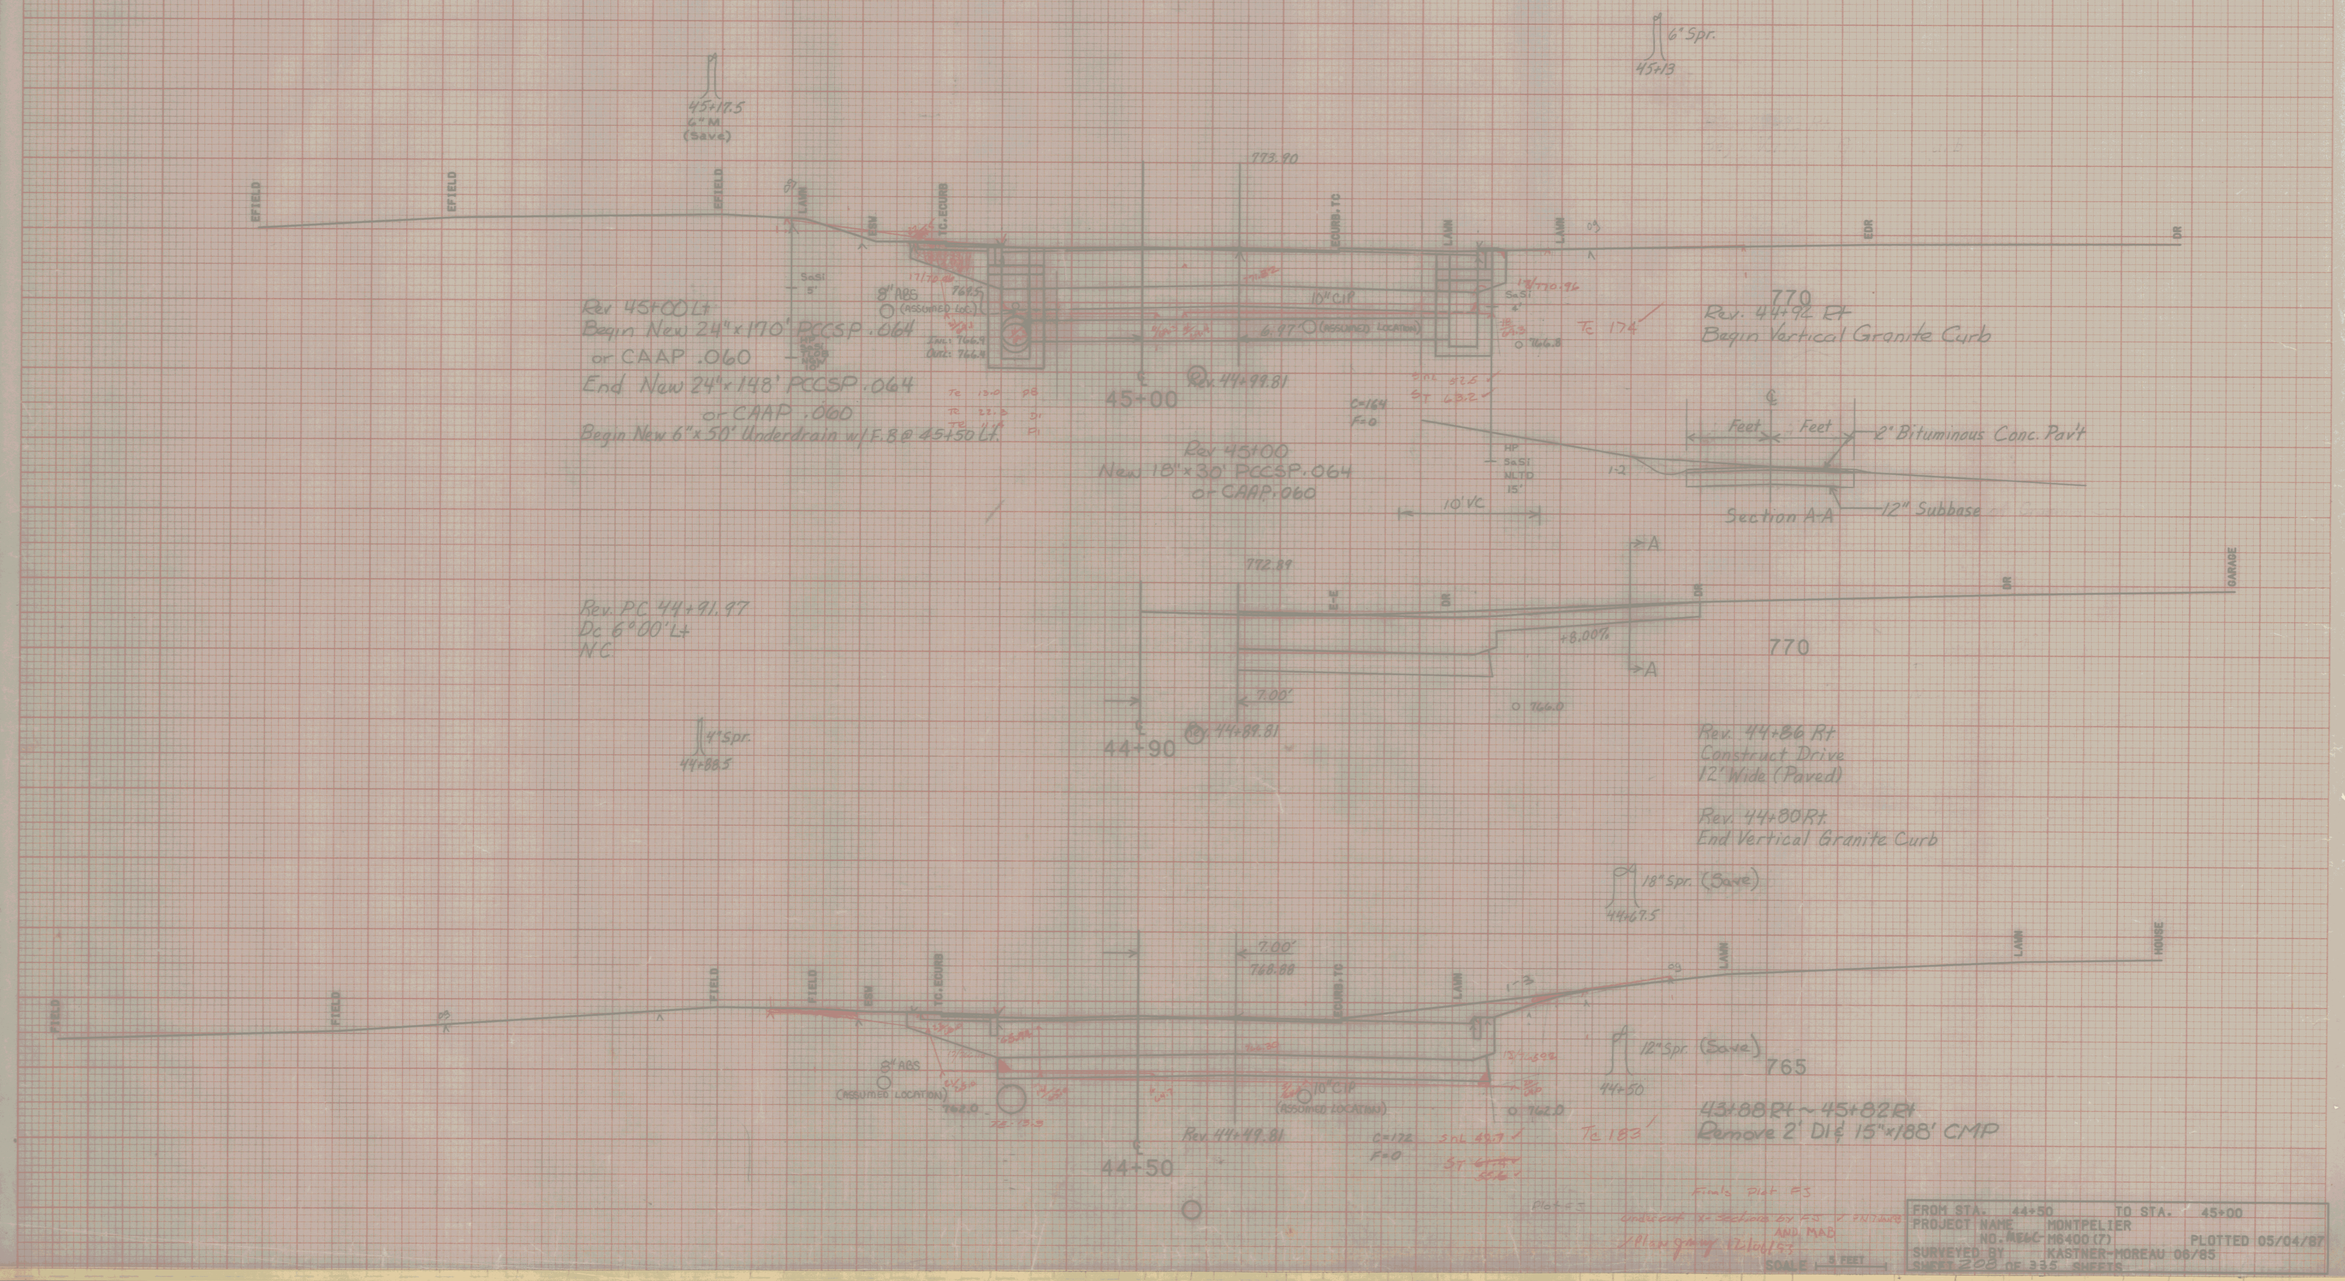
6" Spr.
45+13
45+17.5
6" M
(Save)
EFIELD
EFIELD
EFIELD
LAWN
EBM
TC. EDGRB
793.90
EDGRB. TC
LAWN
LAWN
EDR
DR
770
Rev. 44+92 Rt
Begin Vertical Granite Curb
Rev 45+00 Lt
Begin New 24" x 170' PCCSP .064
or CAAP .060
End New 24" x 148' PCCSP .064
or CAAP .060
Begin New 6" x 50' Underdrain w/ F.B @ 45+50 Lt.
8" ABS
(ASSUMED LOC.)
10" CIP
6.97 (ASSUMED LOCATION)
Rev. 44+99.81
45+00
Rev 45+00
New 18" x 30' PCCSP .064
or CAAP .060
Feet
Feet
2" Bituminous Conc. Pav't
12" Subbase
Section A-A
10' VC
A
A
792.89
DR
DR
DR
GARAGE
+8.00%
770
Rev. PC 44+91.97
Dc 6°00' Lt
NC
4" Spr.
44+88.5
7.00'
44+89.81
44+90
Rev. 44+86 Rt
Construct Drive
12' Wide (Paved)
Rev. 44+80 Rt
End Vertical Granite Curb
18" Spr. (Save)
44+67.5
FIELD
FIELD
FIELD
FIELD
EBM
TC. EDGRB
7.00'
768.88
EDGRB. TC
LAWN
LAWN
LAWN
HOUSE
12" Spr. (Save)
44+50
765
8" ABS
(ASSUMED LOCATION)
10" CIP
(ASSUMED LOCATION)
Rev. 44+49.81
44+50
43+88 Rt ~ 45+82 Rt
Remove 2' DI & 15" x 188' CMP
FROM STA. 44+50 TO STA. 45+00
PROJECT NAME MONTPELIER
NO. RE&C M6400 (7) PLOTTED 05/04/87
SURVEYED BY KASTNER-MOREAU 06/85
SHEET 208 OF 355 SHEETS
SCALE 5 FEET