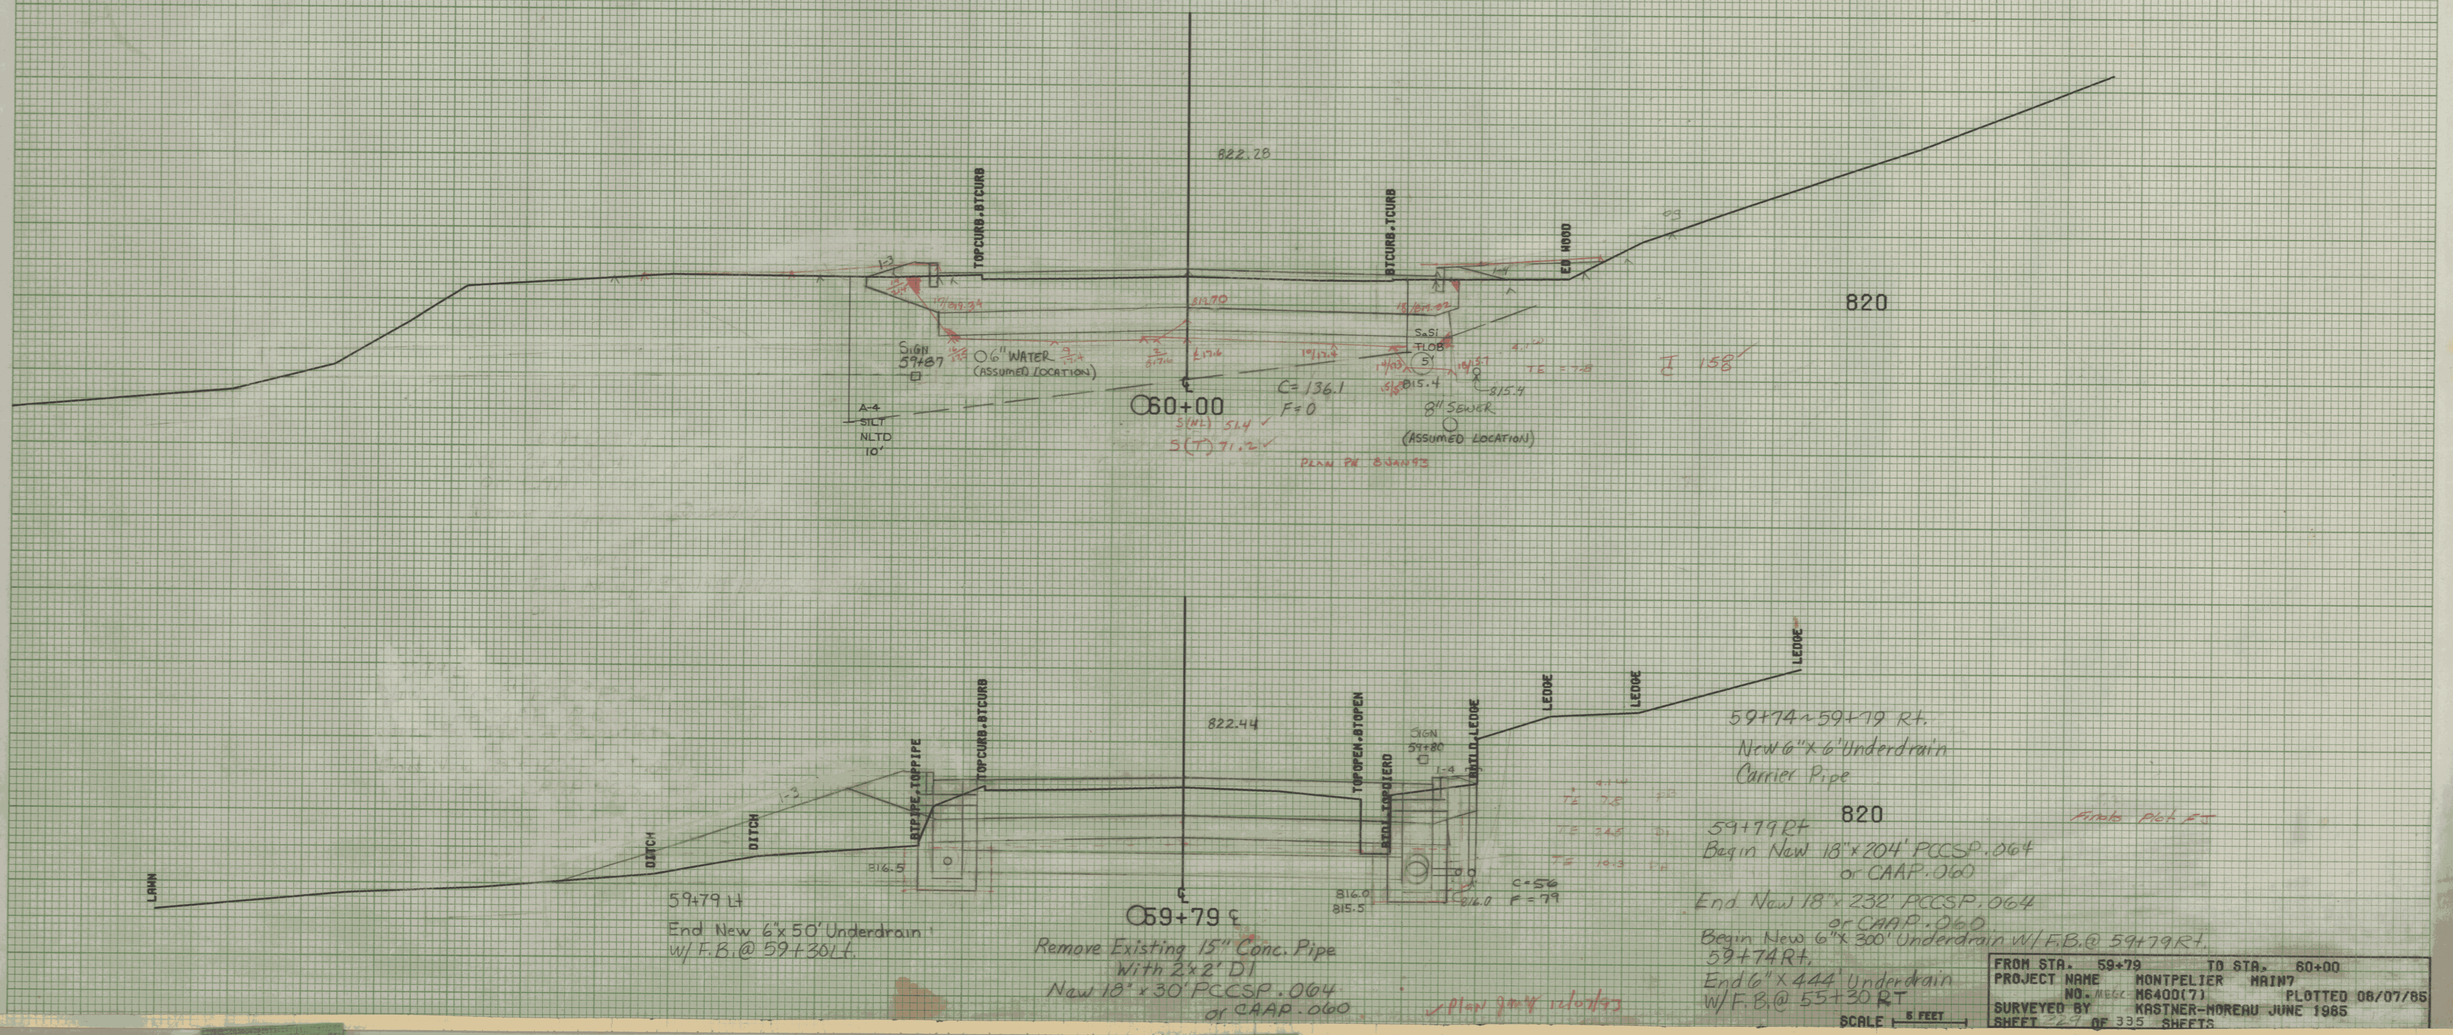
822.28
TOPCURB.BTCURB
BTCURB.TCURB
END HOOD
820
SIGN
59+87
06" WATER
(ASSUMED LOCATION)
C=136.1
F=0
60+00
SaSi
FLOB
5'
815.4
8" SEWER
(ASSUMED LOCATION)
A-4
SILT
NLTD
10'
S(RT) 51.4
S(T) 71.2
PLAN PR 8/24/93
I 158
822.44
LEDGE
LEDGE
LEDGE
TOPOPEN.BTOPEN
BTOPEN.TOPDIERD
SIGN
59+80
EARTH.LEDGE
BTPIPE.TOPPIPE
TOPCURB.BTCURB
DITCH
DITCH
LAWN
816.5
816.0
815.5
816.0
C=56
F=79
59+79 LT
End New 6"x 50' Underdrain
w/ F.B. @ 59+30 LT.
59+79 ℄
Remove Existing 15" Conc. Pipe
With 2'x2' DI
New 18" x 30' PCCSP. 064
or CAAP. 060
59+74 ~ 59+79 RT.
New 6" x 6" Underdrain
Carrier Pipe
820
59+79 RT
Begin New 18" x 204' PCCSP. 064
or CAAP. 060
End New 18" x 232' PCCSP. 064
or CAAP. 060
Begin New 6" x 300' Underdrain W/ F.B. @ 59+79 RT.
59+74 RT.
End 6" x 444' Underdrain
W/ F.B. @ 55+30 RT
Finals Pick EJ
Plan gain includes
SCALE 5 FEET
FROM STA. 59+79 TO STA. 60+00
PROJECT NAME MONTPELIER MAIN7
NO. M6400(7) PLOTTED 08/07/85
SURVEYED BY KASTNER-MOREAU JUNE 1985
SHEET 227 OF 335 SHEETS