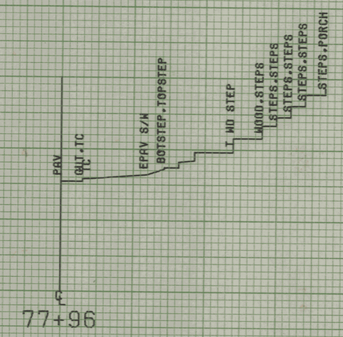

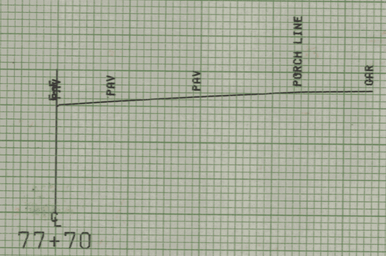

Cold Planing Bituminous Pavement (1½" Deep)
Granite St. Approach 79+55 ~ 80+50 Lt.
River St. Approach 80+00 ~ 86+10 Lt.

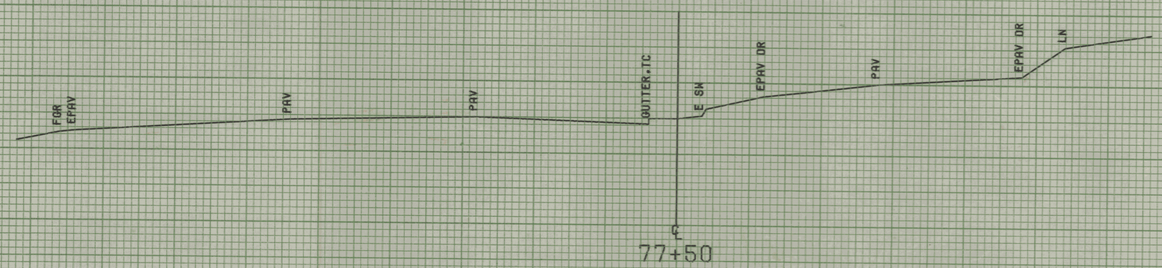

River St. Traverse

SCALE 5 FEET

FROM STA. 77+50 TO STA. 77+96
PROJECT NAME MONTPELIER
NO. M6400(7) PLOTTED 08/07/85
SURVEYED BY KASTNER-MOREAU JUNE 1985
SHEET 292 OF 335 SHEETS