


5+50  
End Construction


October Lane  
5+50 Rt  
Connect Existing 30" CMP  
New 42" x 44" CSP .109 (TO M 18+94 Rt)  
Construct Berm Downstream of DI

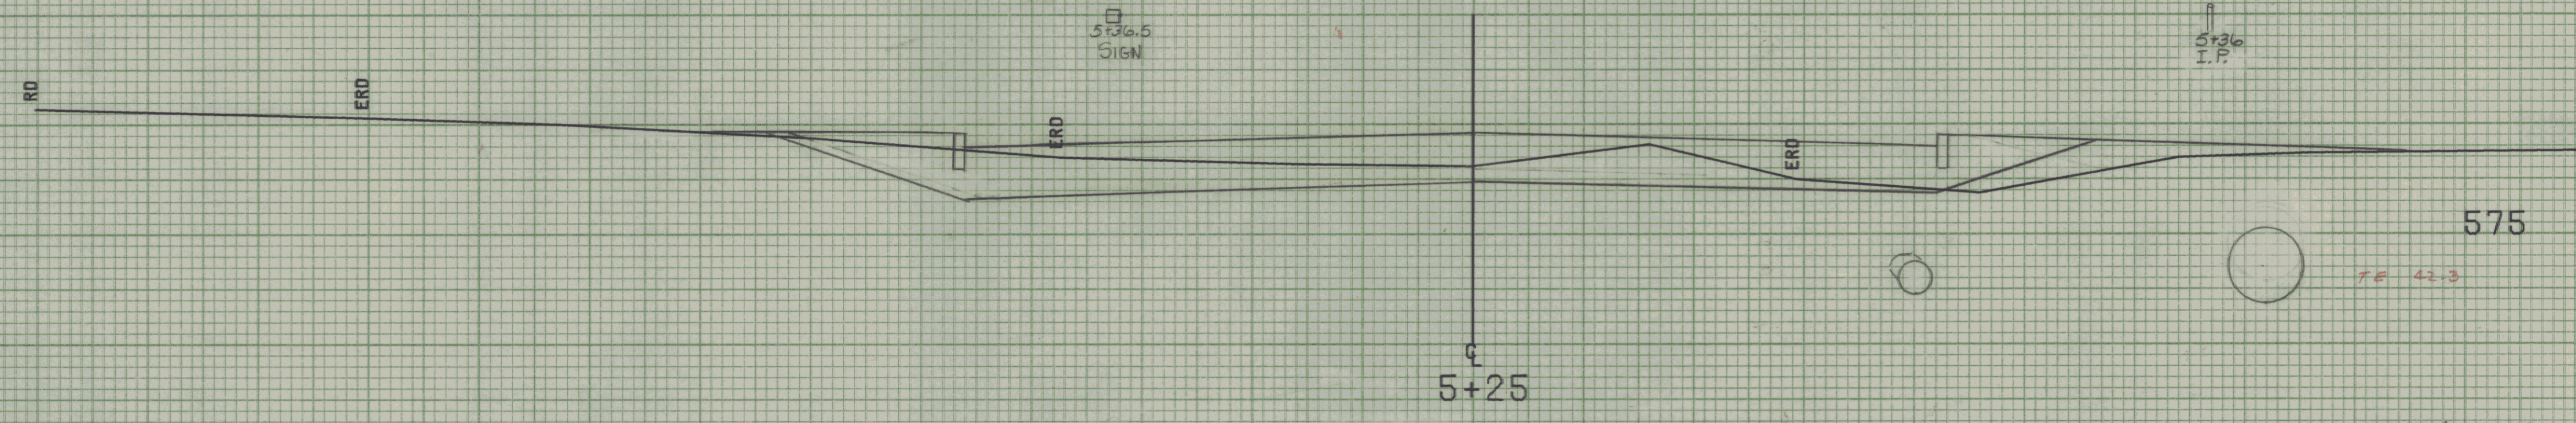

5+25

Oct. Lane 5+50 Lt ~ M 18+94 Rt  
New 18" x 74" PCCSP .064  
or CAAP .060

5+50 Rt ~ M 18+94 Rt.  
Existing RCDI and 30" CMP - Remove

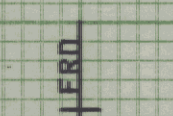

5+22

5+17  
Begin Construction

5+00

M.L. POT 19+34.02 =  
S.L. POT 5+00.00

|              |                          |         |            |
|--------------|--------------------------|---------|------------|
| FROM STA.    | 5+00                     | TO STA. | 5+50       |
| PROJECT NAME | MONTPELIER OCTOBER       |         |            |
| NO.          | M6400(7)                 | PLOTTED | 08/05/85   |
| SURVEYED BY  | KASTNER-MOREAU JUNE 1985 |         |            |
| SHEET        | 255                      | OF      | 335 SHEETS |

SCALE 5 FEET